

X4
10-20-63

WATER WELL DRILLERS LOG

Date: Oct 30, 1963, Driller: Porter Drilling & Log County Wayne
(Name)

(1) Owner of Land: Dolphus Mills
(Name)
Box 3 Wayneboro
(Address)

(2) Location: NE 1/4, NW 1/4, Sec. 3 T. 6 R. 7
5 miles south, of Clara
(distance) (direction) (Nearest Town)

(3) Topography: Hilly
(Hilly) (Flat) (Level)

(4) Purpose of Well: domestic
(Domestic Irrigation
Municipal, Industrial, Other)

Description & Color of Materials Sand, Clay, Red Clay, Shell, etc.	Thick- ness Feet	Depth Feet
<u>hard yellow clay</u>	<u>15</u>	<u>15</u>
<u>coarse sand & shells</u>	<u>10</u>	<u>25</u>
<u>blue chert</u>	<u>5</u>	<u>30</u>
<u>fine white sand</u>	<u>5</u>	<u>35</u>
<u>reddish blue sand</u>	<u>7</u>	<u>41</u>

Information upon completion of well:

(1) Diameter 2" inches.

(2) Total Depth 41' feet.

(3) Water Level 28' feet below top of ground.


(4) Cased to 36', Size 2"

(5) Screen: Size 1 1/4", Length 5'

(6) Were any formations sealed against pollution?
Johnson S.S.
no

If YES depth of formation _____
Why _____

Drillers Remarks: _____

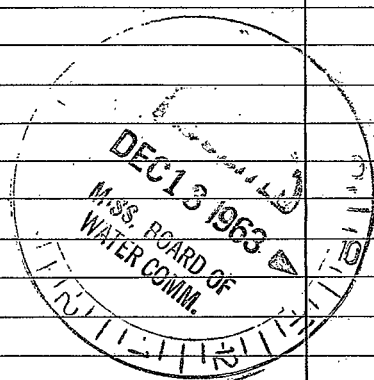

(Use Back Side)

Well No.

