

X5

4-15-61

WATER WELL DRILLERS LOG

X-301

Date April 15, 1961, Driller: D. N. Porter Son County Wayne

(Name)

Wayne Feed Store

(1) Owner of Land: J. L. Martin

(Name)

(2) Location: Rt 3 Waynesboro Miss

(Address)

(2) Location: NW 1/4, NE 1/4, Sec. 3 T6 R7

12 miles S of Waynesboro

(distance)

(direction)

(Nearest Town)

(3) Topography: hilly

(Hilly)

(Flat)

(Level)

(4) Purpose of Well: domestic

(Domestic Irrigation
Municipal, Industrial, Other)

Description & Color of Materials Sand, Clay, Red Clay, Shell, etc.	Thick- ness Feet	Depth Feet
Clay 10'	10'	10'
blue chalk	105	115'
3 1/2' fine sand	3 1/2	108 1/2
2 1/2' chalk	2 1/2	121

Information upon completion of well:

(1) Diameter 2" inches.

(2) Total Depth 121 feet.

(3) Water level 40' feet below top of ground.

(4) Cased to 115, Size 2"

(5) Screen: Size 1 1/4", Length 6'


(6) Were any formations sealed against pollution?

yes, X no.

If YES depth of formation

Why

Drillers Remarks:

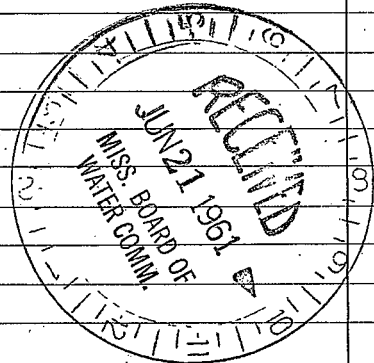

(Use Back Side)

Well No.

