

X 6

7-14-60

WATER WELL DRILLERS LOG

X ~~300~~

Date: 7-14, 1960, Driller: Peoples & Rottedge County Wayne

(Name)

(1) Owner of Land: 199 Roy Cooley  
 (Name)  
Route #3 Wyncesboro.  
 (Address)

(2) Location: 1/4, 1/4, Sec. 5 T R  
6 miles South. of Clara.  
 (distance) (direction) (Nearest Town)


(3) Topography: Hilly  
 (Hilly) (Flat) (Level)

(4) Purpose of Well: Domestic  
 (Domestic Irrigation, Municipal, Industrial, Other)

Description & Color of Materials Sand, Clay, Red Clay, Shell, etc.	Thick- ness Feet	Depth Feet
<u>Yellow Clay</u>	<u>12</u>	<u>12</u>
<u>Sandy Clay</u>	<u>74</u>	<u>88</u>
<u>Blue shale &amp; lign.</u>		
<u>Some lignite</u>	<u>162</u>	<u>275</u>
<u>Grey shale &amp; sand</u>		
<u>Breaks</u>	<u>145</u>	<u>420</u>

Information upon completion of well:

- (1) Diameter 4" inches.
- (2) Total Depth 420 feet.
- (3) Water Level 130 feet below top of ground.
- (4) Cased to 231, Size 4"
- (5) Screen: Size ✓, Length ✓
- (6) Were any formations sealed against pollution?  
no.

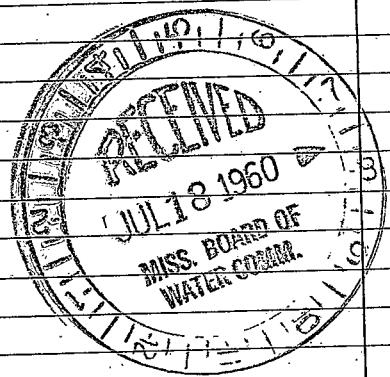

If YES depth of formation \_\_\_\_\_  
 Why \_\_\_\_\_

Drillers Remarks: fine silty sand  
first H2O sand -

Well No.

(Use Back Side)

Mail this copy to Board of Water