

WAYNE MISSISSIPPI BOARD OF WATER COMMISSIONERS

5307

X7
7-5-61

WATER WELL DRILLERS LOG


Date July 5, 1961, Driller: D. N. Porter Don County Wayne
(Name)

(1) Owner of Land:	Description & Color of Materials Sand, Clay, Red Clay, Shell, etc.	Thick- ness Feet	Depth Feet
<u>Luther B. Pittman</u> (Name)	<u>Clay</u>	<u>10</u>	<u>10</u>
<u>Rt 3 Haynesboro, Miss.</u> (Address)	<u>blue chalk</u>	<u>132</u>	<u>142</u>
(2) Location: <u>SE 1/4, NE 1/4, Sec. 8 T. 7 R. 7</u>	<u>sand & chalk</u>	<u>5</u>	<u>147</u>
<u>0.9</u> miles <u>south</u> , of <u>Clara</u> (distance) (direction) (Nearest Town)	<u>sand</u>	<u>6</u>	<u>153</u>
(3) Topography: <u>hilly</u> (Hilly) (Flat) (Level)	<u>stop on chalk</u>		
(4) Purpose of Well: <u>domestic</u> (Domestic Irrigation Municipal, Industrial, Other)			

Information upon completion of well:

- (1) Diameter 2" inches.
- (2) Total Depth 153' feet.
- (3) Water Level 81' feet below top of ground.
- (4) Cased to 145', Size 2"
- (5) Screen: Size 1 1/4 80m Length 6'
- (6) Were any formations sealed against pollution?
yes, X no.

If YES depth of formation _____
Why _____
Drillers Remarks: _____

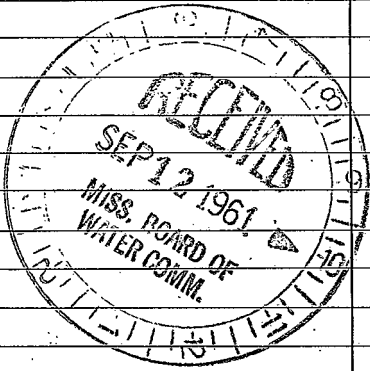

(Use Back Side)

Well No.

