

WAYNE MISSISSIPPI BOARD OF WATER COMMISSIONERS

X8

4-2-63

WATER WELL DRILLERS LOG

Date: April 2, 1963, Driller: Porter Drilling & Log County Wayne  
 (Name)

(1) Owner of Land: Kershal Smith  
 (Name)  
211 State Line  
 (Address)

(2) Location: NE 1/4, SW 1/4, Sec 23 T6 R7,  
12 miles west, of State Line  
 (distance) (direction) (Nearest Town)

(3) Topography: flat  
 (Hilly) (Flat) (Level)

(4) Purpose of Well: domestic  
 (Domestic Irrigation  
 Municipal, Industrial, Other)

Description & Color of Materials Sand, Clay, Red Clay, Shell, etc.	Thick- ness Feet	Depth Feet.
<u>red clay</u>	<u>8</u>	<u>8</u>
<u>blue sand</u>	<u>14</u>	<u>22</u>
<u>blue chalk</u>	<u>154</u>	<u>176</u>
<u>med grade clean sand</u>	<u>13</u>	<u>189</u>
<u>chalky sand</u>	<u>12</u>	<u>201</u>
<u>med. clean sand</u>	<u>6</u>	<u>207</u>
<u>med. coarse sand</u>	<u>7</u>	<u>214</u>
<u>stagnant coarse</u>		
<u>chalky sand</u>		

Information upon completion of well:

(1) Diameter 2' inches.

(2) Total Depth 214' feet.

(3) Water Level 31' feet below top of ground.

(4) Cased to 183', Size 2''


(5) Screen: Size 1/4, Length 12'  
80 ga

(6) Were any formations sealed against pollution?  
yes,  no.

If YES depth of formation \_\_\_\_\_

Why \_\_\_\_\_

Drillers Remarks: \_\_\_\_\_

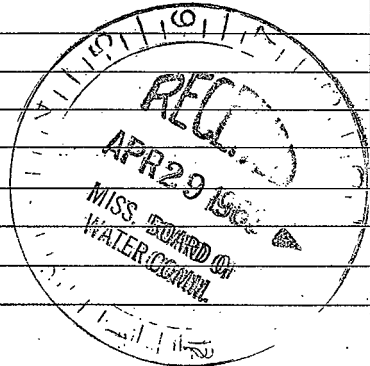

(Use Back Side)

Well No.

