

WAYNE MISSISSIPPI BOARD OF WATER COMMISSIONERS

X9

8-27-65

WATER WELL DRILLERS LOG

Date: Aug 27, 1965, Driller: Porta Drilling Co County Wayne
 (Name)


(1) Owner of Land: <u>Bilbo O'Neal</u> (Name)	Description & Color of Materials Sand, Clay, Red Clay, Shell, etc.	Thick- ness Feet	Depth Feet
<u>241 State Line Miss</u> (Address)	<u>red clay</u>	<u>8</u>	<u>8</u>
(2) Location: <u>NW 1/4, SE 1/4, Sec 24 T6 R 7</u>	<u>sand & chalk</u>	<u>20</u>	<u>28</u>
<u>15</u> miles <u>South</u> of <u>Thyng</u> (distance) (direction) (Nearest Town)	<u>blue chalk</u>	<u>12</u>	<u>40</u>
(3) Topography: <u>Hilly</u> (Hilly) (Flat) (Level)	<u>red chalk</u>	<u>14</u>	<u>54</u>
(4) Purpose of Well: <u>Domestic</u> (Domestic Irrigation Municipal, Industrial, Other)	<u>blue chalk</u>	<u>66</u>	<u>120</u>
	<u>fine sand</u>	<u>3</u>	<u>123</u>
	<u>chalk & fine sand</u>	<u>7</u>	<u>130</u>
	<u>soft blue chalk</u>	<u>30</u>	<u>160</u>
	<u>med coarse sand</u>	<u>15</u>	<u>175</u>
	<u>stayed w/ steel in sand</u>		

Information upon completion of well:

- (1) Diameter 2' inches.
- (2) Total Depth 175' feet.
- (3) Water Level 124' feet below top of ground.
- (4) Cased to 168', Size 2"
- (5) Screen: Size 1 1/4", Length 5'
Johnson S.S. 8 slot
- (6) Were any formations sealed against pollution?
 yes, no.

If YES depth of formation _____
 Why _____

Drillers Remarks: _____

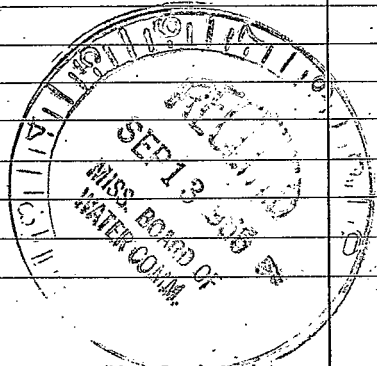

(Use Back Side)

Well No.

