

31° 27' 52"

88° 39' 10"

WAYNE

X 13

4-68

MISSISSIPPI
 BOARD OF WATER COMMISSIONERS
 416 North State Street
 Jackson, Mississippi 39201

WATER WELL DRILLERS LOG

April 11, 1968 Porter Drilling Co. Wayne
 date well completed firm name county well located

LANDOWNER: W.C. Smith

At 1 State Line

Miss

(mailing address)

WELL LOCATION:

see 24 T 60 S R 7 E
8 miles south of Clara
 (distance) (direction) (nearest town)

WELL PURPOSE: home
 (home, irrigation, municipal, industrial)

WELL COMPLETION DATA:

- (1) diameter (inches) 2"
- (2) total depth (feet) 194
- (3) static water level (feet) 111 ^{below}/_{above} top of ground.
- (4) casing steel, 189'
 (material) (depth)
2" if telescope see back.
 (size)
- (5) screen 5', 189'
 (length) (depth to top)
1/4", Johnson 8 slot S.S.
 (size) (material)
- (6) pump 2, 7
 (HP) (yield gpm)
elec
 (type power)
- (7) electric log no
 (yes or no)

(organization running log)


(8) how well bottom plugged flush screen

DRILLERS REMARKS:

description of formations encountered


from to

rest clay	0	8
red sand	8	20
chalk	20	38
sand	38	41
blue chalk	41	57
red sand	57	70
blue chalk	70	90
sand	90	92
blue chalk	92	122
strat of fine sand to chalk	122	185
next coarse sand	185	194
stagnant white steel in sand		

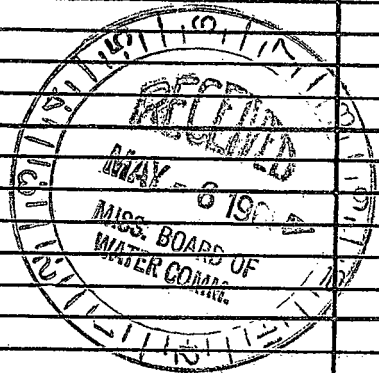

If well telescopes please sketch and show depths.

GROUND LEVEL

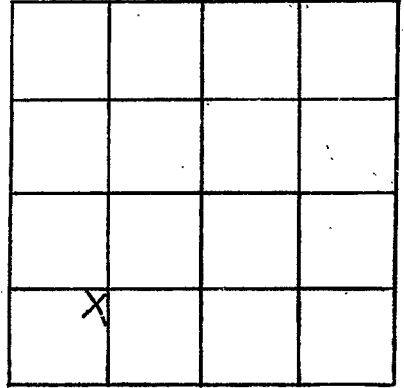

SECTION 24

Please indicate well location X.

ADDITIONAL INFORMATION

If more than one screen, show locations of each on sketch.