

**MISSISSIPPI
BOARD OF WATER COMMISSIONERS**
416 North State Street
Jackson, Mississippi 39201

WATER WELL DRILLERS LOG

Wayne
X14
7-68

July 12 1968 Porter Drilling & Sup Wayne
date well completed firm name county well located

LANDOWNER: Buford Berry
Rt 3 Waynesboro, Miss
(mailing address)

description of formations encountered	from	to
red chalk	0	9
white chalk	9	38
fine sand & chalk	38	50
blue chalk	50	155
Chalk & sand	155	165
clean red fire sand striped on chalk	165	172

WELL LOCATION: 6
sec. 5 T. 2 N. R. 7 E.
4 miles S of Clava
(distance) (direction) (nearest town)

WELL PURPOSE: home
(home, irrigation, municipal, industrial)

WELL COMPLETION DATA:

(1) diameter (inches) 2"

(2) total depth (feet) 172'

(3) static water level (feet) 98' (below)
top of ground.

(4) casing steel, 166'
(material) (depth)
2" if telescope see back.
(size)

(5) screen 6', 166'
(length) (depth to top)
1/4" 80 ga brass jacket
(size) (material)

(6) pump 2 7
(HP) (yield gpm)
elec
(type power)

(7) electric log no
(yes or no)

(organization running log)


(8) how well bottom plugged
flush point

DRILLERS REMARKS:
screen test in with
Packer
117' 1/4" drop pipe

JUL 15 1968
MISS. BOARD OF
WATER COM. STAMP

If well telescopes please sketch and show depths.

GROUND LEVEL

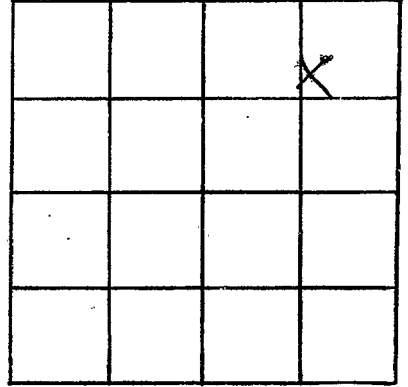

SECTION 5

Please indicate well location X.

ADDITIONAL INFORMATION

If more than one screen,
show locations of each on sketch.