

Wayne
X15
1-16-69

MISSISSIPPI
BOARD OF WATER COMMISSIONERS
416 North State Street
Jackson, Mississippi 39201

CODED

WATER WELL DRILLERS LOG

CODED

Jan 16 1969 date well completed
Pant Drilling & Inc. firm name
Wayne county well located

LANDOWNER: Mrs D. Alfus
mill
At 3 N. W. Highway Miss
(mailing address)

description of formations encountered	from	to
red clay	0	8
sand	8	22
Chalk	22	35
sand	35	41
blue chalk	41	78
fine sand & chalk	78	86
blue chalk	86	110
Chalk & fine sand	110	132
stiff blue chalk	132	150
fine sand	150	158
blue chalk	158	177
fine sand	177	184
Chalk	184	190
med fine sand	190	194
stiff blue chalk	194	213
fine sand & chalk	213	220
thin clean sand	220	231
house clean sand	231	232
stopped white steel mill sand		

WELL LOCATION:
sec. 3 T 6 N R 7 E
5 S 4 W
miles S of Clava
(distance) (direction) (nearest town)

WELL PURPOSE: home
(home, irrigation, municipal, industrial)

WELL COMPLETION DATA:
(1) diameter (inches) 2"
(2) total depth (feet) 238'
(3) static water level (feet) 50' below top of ground.
(4) casing steel 231' (material) (depth)
2" If telescope see back. (size)
(5) screen 6' 232' (length) (depth to top)
1 1/4" 60gr S.S. (size) (material)
(6) pump 3/4 7 1/2 (HP) (yield gpm)
elec (type power)
(7) electric log none (yes or no)
(organization running log)
(8) how well bottom plugged
flank sand


158 177
177 184
184 190
190 194
194 213
213 220
220 231
231 232
CODED
6' 1 1/4" 60gr S.S. with
2' 1 1/4" by wire basket
with preser
6' 3' 1 1/4" clay pipe

DRILLERS REMARKS:

FEB 7 1969
MISS. Bd. of WATER COMMISSIONERS

If well telescopes please sketch and show depths.

GROUND LEVEL

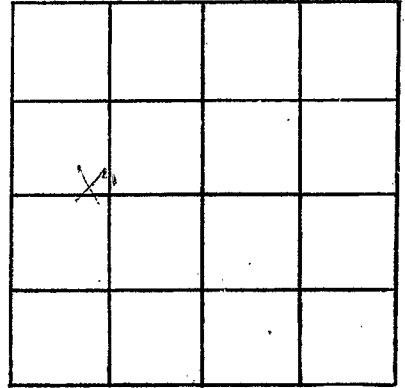

SECTION 3

Please indicate well location X.

ADDITIONAL INFORMATION

If more than one screen,
show locations of each on sketch.