

CODED

MISSISSIPPI
BOARD OF WATER COMMISSIONERS
416 North State Street
Jackson, Mississippi 39201

WATER WELL DRILLERS LOG

Wayne
X 16
2-27-69

Feb. 27, 1969 date well completed
B. B. Drilling & Pump firm name
Wayne county well located

LANDOWNER: Carl Holliman

description of formations encountered

Rt 3 Wagoner Miss.
(mailing address)

red clay
red chalk
white chalk
red chalk
blue chalk
lime sand
blue chalk
lime clean sand
blue chalk
lime sand & chalk
blue chalk
red sand & chalk
brown sand
white sand & chalk
lime sand
lime clean sand
red coarse sand
stagnant white shell
lime & coarse sand

WELL LOCATION:
sec. 4 T. 60 N. R. 7 E.
6 miles S of Claron
(distance) (direction) (nearest town)

from to
0 12
17 22
23 33
38 47
47 67
68 90
90 119
119 126
126 152
152 160
160 176
179 203
225 227
227 231
231 265
265 271
271 275

WELL PURPOSE: dom
(home, irrigation, municipal, industrial)

WELL COMPLETION DATA:

(1) diameter (inches) 2"

(2) total depth (feet) 278'

(3) static water level (feet) 93 ^{below} 271' _{above}
top of ground.

(4) casing steel 271'
(material) (depth)

2" if telescope see back.
(size)

(5) screen 6' 272
(length) (depth to top)

1/4" 60 ga S.S.
(size) (material)

(6) pump 1 1/2 10
(HP) (yield gpm)

elec.
(type power)

(7) electric log no
(yes or no)

(organization running log)

(8) how well bottom plugged
plugged

DRILLERS REMARKS:


6" 1/4" ^{CODED} 60 ga S.S. with
3" 1/4" log sheet with
reacher
105' 1/4" drop pipe

MAR 24 1969

MISS. BD. OF
WATER COMM.

If well telescopes please sketch and show depths.

GROUND LEVEL

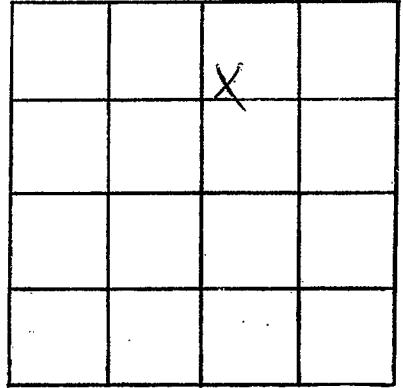

SECTION 4

Please indicate well location X.

ADDITIONAL INFORMATION

If more than one screen,
show locations of each on sketch.