

WAYNE

X 20

2-26-74

MISSISSIPPI BOARD OF WATER COMMISSIONERS

416 North State Street
Jackson, Mississippi 39201

CODED

WATER WELL DRILLERS LOG

Date well completed Feb. 26 1974 Port. Drillers & Supply firm name Wayne county well located

LANDOWNER: Pauline Anderson

description of formations encountered

from to

Box 3 Magnolia Ave
Miss
(mailing address)

red clay 0 8
sand 8 22
chuck 22 76
red chuck sand 76 86
blue chuck 86 92
orange clay sand 92 99
red chuck sand 99 100
Edge of on chuck

WELL LOCATION:

sec. 18 T. 60 N. R. 7 E.
6 miles S of Clona
(distance) (direction) of (nearest town)

WELL PURPOSE: home
(home, irrigation, municipal, industrial)

WELL COMPLETION DATA:

- (1) diameter (inches) 2"
- (2) total depth (feet) 100'
- (3) static water level (feet) 57' below top of ground.
- (4) casing PVC 94'
(material) (depth)
- 2'
(size) if telescope see back.
- (5) screen 5' 94'
(length) (depth to top)
- 1/4" SS.
(size) (material)
- (6) pump 1 12
(HP) (yield gpm)
- elec.
(type power)
- (7) electric log no
(yes or no)
- (organization running log)

5' 1" solid S section
on end of cas. well
had wash valve on end
and shell & pipe above

72' 1" P.V.C. drop pipe
P.V.C.

CODED


(8) how well bottom plugged
back with water

DRILLERS REMARKS:

MAR 11 1974

If well telescopes please sketch and show depths.

GROUND LEVEL

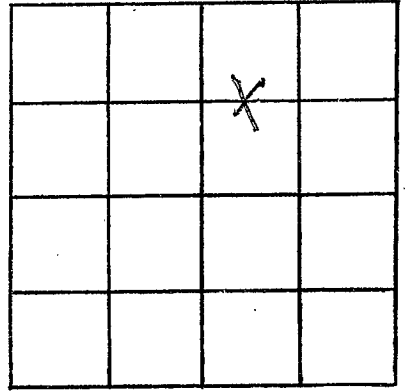

SECTION 18

Please indicate well location X.

ADDITIONAL INFORMATION

If more than one screen,
show locations of each on sketch.