

WAYNE  
X 21  
2-21-74

MISSISSIPPI  
BOARD OF WATER COMMISSIONERS  
416 North State Street  
Jackson, Mississippi 39201

WATER WELL DRILLERS LOG

CODED

Feb 21 1974 date well completed  
Porter Drilling & Log firm name  
Sharps county well located

LANDOWNER: Arthur Pittman

description of formations encountered

from to

At 3 Sharpsboro Miss  
(mailing address)

WELL LOCATION:

sec. 9 T. 6 N. R. 7 E.  
5 miles S of Clara  
(distance) (direction) (nearest town)

rest clay & chalk 0 20  
blue chalk 20 41  
sand 41 45  
chalk 45 50  
chalk & sand 50 71  
sand 71 78  
stagnant on shaft  
rest of a 1/2 mile  
west back

WELL PURPOSE: Home  
(home, irrigation, municipal, industrial)

WELL COMPLETION DATA:


- (1) diameter (inches) 2"
- (2) total depth (feet) 78'
- (3) static water level (feet) 71' below top of ground.
- (4) casing steel 73' (material) (depth)  
2" (size) If telescope see back.
- (5) screen 5' 73' (length) (depth to top)  
1/2" (size) Galv. S.S. (material)
- (6) pump 1 10 (HP) (yield gpm)  
elec (type power)
- (7) electric log no (yes or no)

5' 1/2" hole ss. with  
2' 1/2" long pipe stuck in  
with grout  
42' 1/2" drop pipe  
CODED

(organization running log)

(8) how well bottom plugged  
flush point


DRILLERS REMARKS:

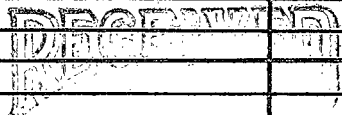

MAR 1 1974

If well telescopes please sketch and show depths.

GROUND LEVEL

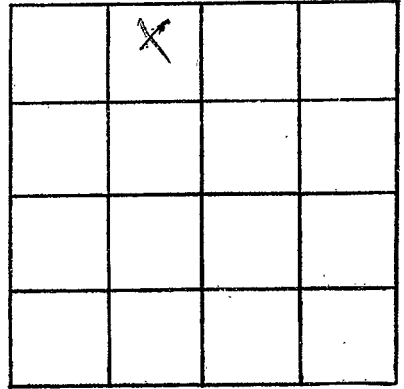

SECTION 9

Please indicate well location X.

ADDITIONAL INFORMATION

If more than one screen,  
show locations of each on sketch.