

Wayne  
 X 22  
 5-27-75

MISSISSIPPI  
 BOARD OF WATER COMMISSIONERS  
 416 North State Street  
 Jackson, Mississippi 39201

CODED

WATER WELL DRILLERS LOG

May 27 1975 Porter Drilling, Inc. Wayne  
 date well completed firm name county well located

LANDOWNER: Jamie B. Manning Rt 3 Box 326 Waynesboro  
 (mailing address)

WELL LOCATION:  
 sec 18 T 6 N R 7 13P  
6 miles S of Clava  
 (distance) (direction) (nearest town)

WELL PURPOSE: home  
 (home, irrigation, municipal, industrial)

WELL COMPLETION DATA:

(1) diameter (inches) 2'

(2) total depth (feet) 452

(3) static water level (feet) 147 (below/above top of ground)

(4) casing PVC 446'  
 (material) (depth)

2' If telescope see back.  
 (size)

(5) screen 6' 446'  
 (length) (depth to top)

2' 6' x 1/2"  
 (size) (material)

(6) pump 3/4 HP 3 1/2  
 (HP) (yield gpm)

elec.  
 (type power)

(7) electric log no  
 (yes or no)

(organization running log)

(8) how well bottom plugged back with valve


description of formations encountered	from	to
red clay to sand	0	10
clay	10	155
clay to some sand	155	160
clay	160	270
fine light sand	270	290
clay	290	292
fine sand	292	309
clay	309	321
fine sand to clay	321	325
hard fine grained sand	325	330
soft clay to sand	330	337
sand to clay	337	446
red clean sand	446	452
clay	452	460
fine sand to clay	460	470
stiff clay	470	480
6' 2" x 1/2" steel pipe		
in end of PVC casing		
will both work with		
or end of shaft with		
above		
168' 1/4" diameter		
drop pipe with		
3.10 HP		
8 year pump rods		
13 1/2" cylinder		
of dog pipe		

PORTER DRILLING, INC.  
 JACKSON, MISSISSIPPI  
 MAY 26 1975

MISS. BD. OF WATER COMMISSIONERS

If well telescopes please sketch and show depths.

GROUND LEVEL

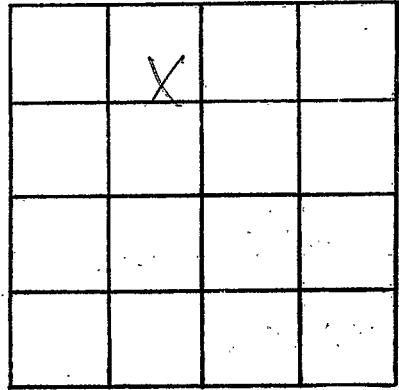

SECTION 18

Please indicate well location X.

ADDITIONAL INFORMATION

Multiple horizontal lines for additional information.

If more than one screen, show locations of each on sketch.