

MISSISSIPPI DEPARTMENT OF NATURAL RESOURCES

Bureau of Land and Water Resources

Southport Mall

P.O. Box 10631

Jackson, Mississippi 39209

WATER WELL DRILLERS LOG

X 24
Wayne

April 10 1985 Porter Drilling & Log. Wayne
date well completed firm name county well located


LANDOWNER: Kiel Davis
At 1 Bay 319 A
State Line Mo. 39362
(mailing address)

description of formations encountered	from	to
clay	0	7
sand	7	14
clay some fine sand	14	57
hard med. sand	57	66
vertical on sandy clay		
40' 1" P.V.C. pipe		

WELL LOCATION:
sec. 24 T 6 N R 7 E
7 miles S of Clucora
(distance) (direction) (nearest town)

WELL PURPOSE: home
(home, irrigation, municipal, industrial)

- WELL COMPLETION DATA:
- (1) diameter (inches) 2"
 - (2) total depth (feet) 66'
 - (3) static water level (feet) 31' (below/above top of ground)
 - (4) casing P.V.C. 61'
(material) (depth)
 - 2" if telescope see back.
(size)
 - (5) screen 5' 61'
(length) (depth to top)
 - 2" Salt P.V.C.
(size) (material)
 - (6) pump 1 12
(HP) (yield gpm)
 - elec.
(type power)
 - (7) electric log no
(yes or no)
 - (organization running log)
 - (8) how well bottom plugged 2" sand slant

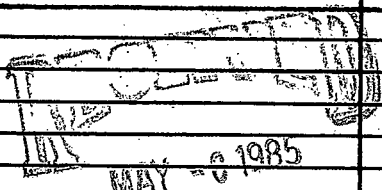


DRILLERS REMARKS:

Department of Natural Resources
Bureau of Land & Water Resources

If well telescopes please sketch and show depths.

GROUND LEVEL

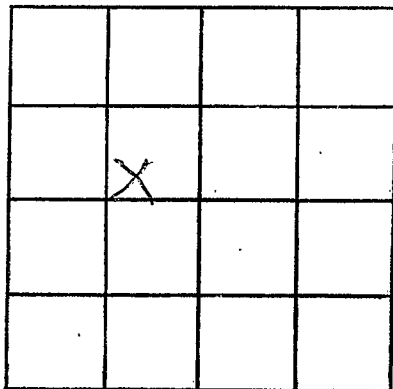

SECTION 24

Please indicate well location X.

ADDITIONAL INFORMATION

If more than one screen,
show locations of each on sketch.