

**MISSISSIPPI DEPARTMENT OF NATURAL RESOURCES**  
**Bureau of Land and Water Resources**  
 Southport Mall  
 P.O. Box 10631  
 Jackson, Mississippi 39209  
**WATER WELL DRILLERS LOG**

Wayne  
X 2003

March 16 1982 Bob's Drilling & Pump Wayne  
 date well completed firm name county well located

**LANDOWNER:** Mrs E. N. Robinson Rt 3  
Box 665 Haynesboro  
 (mailing address)

description of formations encountered	from	to
<u>sand</u>	<u>0</u>	<u>5</u>
<u>clay</u>	<u>5</u>	<u>25</u>
<u>sand &amp; clay</u>	<u>25</u>	<u>40</u>
<u>clay &amp; sand</u>	<u>40</u>	<u>50</u>
<u>sand &amp; clay</u>	<u>50</u>	<u>52</u>
<u>sand</u>	<u>52</u>	<u>55</u>
<u>clay &amp; sand</u>	<u>55</u>	<u>57</u>

**WELL LOCATION:**  
 sec. 18 T 6 N R 7 E  
6 miles S of Clara  
 (distance) (direction) (nearest town)

**WELL PURPOSE:** home  
 (home, irrigation, municipal, industrial)

1 1/2" PVC drop pipe

**WELL COMPLETION DATA:**

(1) diameter (inches) 2"

(2) total depth (feet) 57

(3) static water level (feet) 34' below top of ground.

(4) casing PVC 52'  
 (material) (depth)

2'  
 (size) If telescope see back.

(5) screen 5' 52'  
 (length) (depth to top)

2" galv SS  
 (size) (material)

(6) pump 1 8  
 (HP) (yield gpm)

elec.  
 (type power)

(7) electric log no  
 (yes or no)

(organization running log)

(8) how well bottom plugged  
2" sand slash

**DRILLERS REMARKS:**


DEPT. OF NATURAL RESOURCES  
 BUREAU OF LAND & WATER RESOURCES

APR 20 1982

**RECEIVED**

If well telescopes please sketch and show depths.

GROUND LEVEL

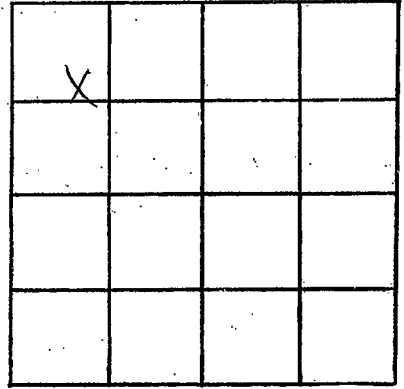

SECTION 18

Please indicate well location X.

ADDITIONAL INFORMATION

If more than one screen, show locations of each on sketch.