

MISSISSIPPI DEPARTMENT OF NATURAL RESOURCES

Bureau of Land and Water Resources

Southport Mall

P.O. Box 10631

Jackson, Mississippi 39209

WATER WELL DRILLERS LOG

Wayne
X 2004

Oct 2 1984 date well completed
24 Porter Drilling & Log firm name
Wayne county well located

LANDOWNER: Martin Jones
Box 324
State Line Mo.
(mailing address)

description of formations encountered	from	to
clay	0	9
sand	9	15
clay & sand	15	72
clean sand to coarse sand at bottom	72	79
stagnant white shell sand		

WELL LOCATION:
sec. 24 T. 6 N. R. 7 E. S. 1 W.
7 miles (distance) SW (direction) of Shiwoon (nearest town)

WELL PURPOSE: drinking
(home, irrigation, municipal, industrial)

WELL COMPLETION DATA:
(1) diameter (inches) 2"
(2) total depth (feet) 79'
(3) static water level (feet) 30 (below/above top of ground)
(4) casing P.V.C (material) 74' (depth)
2" (size) if telescope see back.
(5) screen 5' (length) 74 (depth to top)
2" (size) galv. P.V.C. (material)
(6) pump 1/2 (HP) 10 (yield gpm)
elec. (type power)
(7) electric log no (yes or no)
(organization running log)
(8) how well bottom plugged 2' sand shell

DRILLERS REMARKS:


DEPT. OF NATURAL RESOURCES
BUREAU OF LAND & WATER RESOURCES

OCT 22 1984

RECEIVED

If well telescopes please sketch and show depths.

GROUND LEVEL

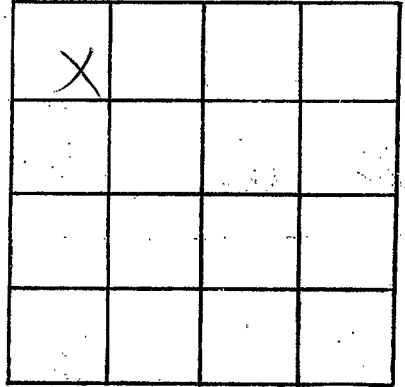

SECTION 24

Please indicate well location X.

ADDITIONAL INFORMATION

If more than one screen,
show locations of each on sketch.