

Y1

11-1-63

WATER WELL DRILLERS LOG

Date: Nov-1, 1963, Driller: Porter Drilling & Pipe County Wayne
 (Name)

- (1) Owner of Land: C. M. Douglas Sr.
 (Name)
At State Line
 (Address)
- (2) Location: SE 1/4, NE 1/4, Sec. 22 T6 R6
9 miles west, of State Line
 (distance) (direction) (Nearest Town)
- (3) Topography: flat
 (Hilly) (Flat) (Level)
- (4) Purpose of Well: domestic
 (Domestic Irrigation
 Municipal, Industrial, Other)


Description & Color of Materials Sand, Clay, Red Clay, Shell, etc.	Thick- ness Feet	Depth Feet
<u>Crowfish clay</u>	<u>8</u>	<u>8</u>
<u>sand</u>	<u>7</u>	<u>15</u>
<u>soft chalk & sand</u>	<u>31</u>	<u>66</u>
<u>hard coarse sand</u>	<u>6</u>	<u>72</u>
<u>sand & chalk</u>	<u>8</u>	<u>80</u>
<u>clean med sand</u>	<u>17</u>	<u>97</u>
<u>hard chalk</u>	<u>8</u>	<u>105</u>
<u>sand & chalk</u>	<u>17</u>	<u>122</u>
<u>fine sand</u>	<u>28</u>	<u>150</u>
<u>course sand</u>	<u>28</u>	<u>178</u>
<u>hard chalk</u>	<u>32</u>	<u>210</u>
<u>fine packy sand</u>	<u>8</u>	<u>218</u>
<u>hard chalk</u>	<u>8</u>	<u>226</u>
<u>sand & chalk</u>	<u>6</u>	<u>232</u>
<u>fine to med sand</u>	<u>30</u>	<u>252</u>
<u>course sand</u>	<u>16</u>	<u>268</u>

Information upon completion of well:

- (1) Diameter: 2" inches.
- (2) Total Depth: 268 feet.
- (3) Water Level: flowed feet below top of ground.
16 gal. per minute
- (4) Cased to: 258', Size 2"
- (5) Screen: Size 1 1/4", Length 10'
Johnson S.S
- (6) Were any formations sealed against pollution?
no.

If YES depth of formation _____
 Why _____

Drillers Remarks: _____

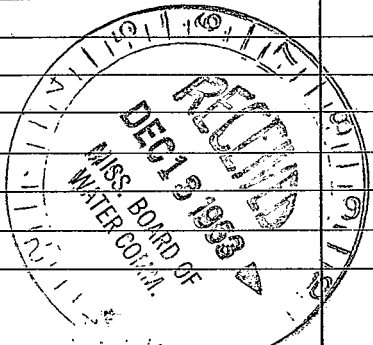

(Use Back Side)

Well No.

