

WAYNE

MISSISSIPPI BOARD OF WATER COMMISSIONERS

Y 2

9-3-62

WATER WELL DRILLERS LOG

Date: Sept. 3, 1962, Driller: Porter Drilling & Log County Wayne  
(Name)

(1) Owner of Land: H. Z. Gray  
(Name)

Lot 2 State Line, Miss  
(Address)

(2) Location: NW 1/4, SE 1/4, Sec. 20 T6 R6,  
8 miles west of State Line,  
(distance) (direction) (Nearest Town)

(3) Topography: Hilly  
(Hilly) (Flat) (Level)

(4) Purpose of Well: domestic  
(Domestic Irrigation, Municipal, Industrial, Other)

Description & Color of Materials Sand, Clay, Red Clay, Shell, etc.	Thick- ness Feet	Depth Feet
<u>red clay</u>	<u>15</u>	<u>15'</u>
<u>sandy chalk</u>	<u>15</u>	<u>30</u>
<u>white chalk</u>	<u>12</u>	<u>42</u>
<u>chalk &amp; streaky fine sand</u>	<u>40</u>	<u>82</u>
<u>blue chalk</u>	<u>28</u>	<u>110</u>
<u>sandy chalk</u>	<u>4</u>	<u>114</u>
<u>medium sand</u>	<u>4</u>	<u>118</u>
<u>blue chalk</u>	<u>62</u>	<u>180</u>
<u>fine sand</u>	<u>4</u>	<u>184</u>
<u>blue chalk</u>	<u>26</u>	<u>210</u>
<u>fine sand</u>	<u>23</u>	<u>233</u>
<u>med sand</u>	<u>13</u>	<u>246</u>

Information upon completion of well:

(1) Diameter 2" inches.

(2) Total Depth 246' feet.

(3) Water Level 145' feet below top of ground.

(4) Cased to 221, Size 2"

(5) Screen: Size 1/4, Length 12'


(6) Were any formations sealed against pollution?

no yes, X no.

If YES depth of formation \_\_\_\_\_

Why \_\_\_\_\_

Drillers Remarks: 1/2 HP Jet

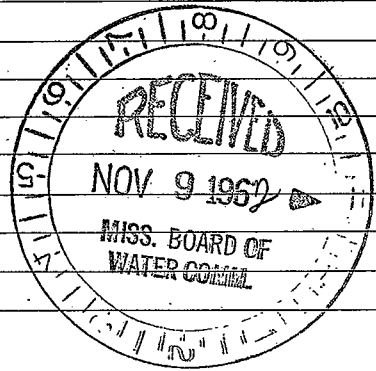

(Use Back Side)

Well No.

