

Y4

11-15-63

WATER WELL DRILLERS LOG

Date: Nov 15, 1963, Driller: Bob Drilling Co County Wayne
 (Name)

(1) Owner of Land: Babe Dawson
 (Name)
Rt 1 Buckatuna
 (Address)
 (2) Location: SW 1/4, SE 1/4, Sec. 3 T6 R6
5 miles SW of Buckatuna
 (distance) (direction) (Nearest Town)
 (3) Topography: Hilly
 (Hilly) (Flat) (Level)
 (4) Purpose of Well: domestic
 (Domestic Irrigation Municipal, Industrial, Other)


Description & Color of Materials Sand, Clay, Red Clay, Shell, etc.	Thick-ness Feet	Depth Feet
<u>chalk</u>	<u>25</u>	<u>25</u>
<u>sand & chalk</u>	<u>7</u>	<u>32</u>
<u>chalk</u>	<u>38</u>	<u>70</u>
<u>fine sand</u>	<u>9</u>	<u>79</u>
<u>med. sand</u>	<u>11</u>	<u>90</u>

Information upon completion of well:

(1) Diameter 2' inches.
 (2) Total Depth 90' feet.
 (3) Water Level 50' feet below top of ground.
 (4) Cased to 84', Size 2'
 (5) Screen: Size 1/4", Length 5'
Johnson S.S
 (6) Were any formations sealed against pollution?
 _____ yes, X no.

If YES depth of formation _____
 Why _____

Drillers Remarks: _____

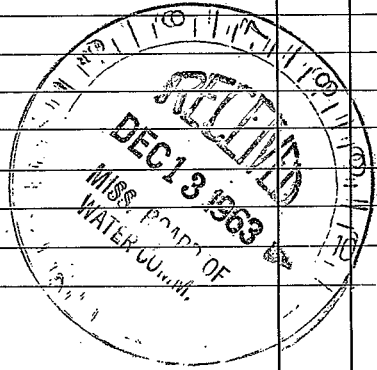

(Use Back Side)

Well No. _____

...the ...

...the ...

