

Y5

9-10-63

WATER WELL DRILLERS LOG

Date: Sept. 10, 1963, Driller: Porter Drilling & Sup County Wayne
(Name)

(1) Owner of Land: Helmer Duggs
(Name)
Rt 1 Buckatanna
(Address)

(2) Location: NW 1/4, NE 1/4, Sec. 2 T6 R6
3 miles SW of Buckatanna
(distance) (direction) (Nearest Town)

(3) Topography: hilly
(Hilly) (Flat) (Level)

(4) Purpose of Well: domestic
(Domestic Irrigation
Municipal, Industrial, Other)

Description & Color of Materials Sand, Clay, Red Clay, Shell, etc.	Thick- ness Feet	Depth Feet
<u>red clay</u>	<u>12</u>	<u>12</u>
<u>course sand</u>	<u>4</u>	<u>16</u>
<u>hard chalk</u>	<u>22</u>	<u>38</u>
<u>soft chalk</u>	<u>2</u>	<u>40</u>
<u>hard chalk</u>	<u>13</u>	<u>53</u>
<u>mixed sand & chalk</u>	<u>10</u>	<u>63</u>
<u>med to course sand</u>	<u>10</u>	<u>73</u>
<u>stopped on chalk</u>		

Information upon completion of well:

(1) Diameter 2" inches.

(2) Total Depth 70' feet.

(3) Water Level 53' feet below top of ground.

(4) Cased to 66, Size 2"


(5) Screen: Size 2", Length 4'

(6) Were any formations sealed against pollution?
 yes, no.

If YES depth of formation _____

Why _____

Drillers Remarks: _____

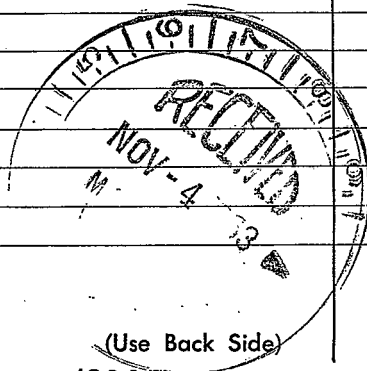

Well No.

