

Y6

2-21-63

WATER WELL DRILLERS LOG


Date: Feb 21, 1963, Driller: Barton Drilling & Log Co. Wayne  
 (Name)

(1) Owner of Land: Navy Patrick  
 (Name)  
Rt 1 Buchatonna  
 (Address)  
 (2) Location: NE 1/4, NE 1/4, Sec 2 T6 R6,  
3 miles SW of Buchatonna  
 (distance) (direction) (Nearest Town)  
 (3) Topography: Hilly  
 (Hilly) (Flat) (Level)  
 (4) Purpose of Well: domestic  
 (Domestic Irrigation  
 Municipal, Industrial, Other)

Description & Color of Materials Sand, Clay, Red Clay, Shell, etc.	Thick- ness Feet	Depth Feet
<u>red sand &amp; clay</u>	<u>10</u>	<u>10</u>
<u>red chalk</u>	<u>10</u>	<u>20</u>
<u>thin rock</u>		<u>20</u>
<u>red chalk</u>	<u>5</u>	<u>25</u>
<u>thin rock</u>		<u>25</u>
<u>red chalk</u>	<u>43</u>	<u>68</u>
<u>sand</u>	<u>55</u>	<u>123</u>
<u>stop while steel</u>		
<u>in sand</u>		

Information upon completion of well:

(1) Diameter 2" inches.  
 (2) Total Depth 123 feet.  
 (3) Water Level 100' feet below top of ground.  
 (4) Cased to 111', Size 2'  
 (5) Screen: Size 1 1/4", Length 6'  
 (6) Were any formations sealed against pollution?  
 \_\_\_\_\_ yes, X no.

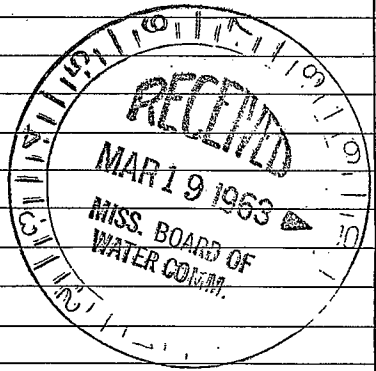

If YES depth of formation \_\_\_\_\_  
 Why \_\_\_\_\_  
 Drillers Remarks: \_\_\_\_\_

(Use Back Side)

Well No.

