

Wayne
y8
6-67

MISSISSIPPI
BOARD OF WATER COMMISSIONERS
416 North State Street
Jackson, Mississippi 39201

WATER WELL DRILLERS LOG

June 14, 1967 date well completed
Porter Drilling & Sps firm name
Wayne county well located

LANDOWNER: E.T. Gordon

description of formations encountered	from	to
	red clay	0
red sand	6	10
chalk	10	15
red sand	15	25
brown clay sandy	25	34
stayed on chalk		

At 1 Buckatanna (mailing address)

WELL LOCATION:
sec. 12 T. 6 N. R. 6 E
4 miles S of Buckatanna
(distance) (direction) (nearest town)

WELL PURPOSE: home
(home, irrigation, municipal, industrial)

WELL COMPLETION DATA:


- (1) diameter (inches) 2"
- (2) total depth (feet) 34'
- (3) static water level (feet) 24 1/2' below top of ground.
- (4) casing steel 30 1/2' (material) (depth)
2' (size) if telescope see back.
- (5) screen 3' 31' (length) (depth to top)
1 1/4" slot Johnson S.S. (size) (material)
- (6) pump 1/2 (HP) 8 (yield gpm)
elec (type power)
- (7) electric log no (yes or no)
- (organization running log)
- (8) how well bottom plugged
flank screen

DRILLERS REMARKS:



If well telescopes please sketch and show depths.

GROUND LEVEL

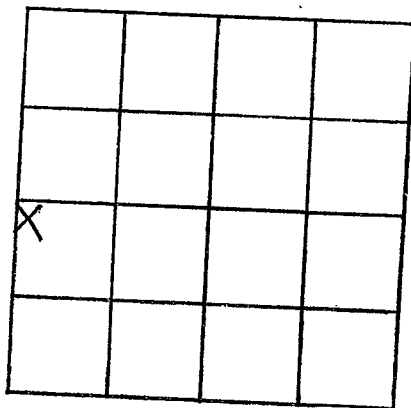

SECTION 12

Please indicate well location X.

ADDITIONAL INFORMATION

If more than one screen,
show locations of each on sketch.