

WAYNE

MISSISSIPPI BOARD OF WATER COMMISSIONERS

Y 12

6-30-65

WATER WELL DRILLERS LOG

Date: June 30, 1965, Driller: Carter Drilling Co. County: Wayne

(1) Owner of Land: Gold Glen Henderson
(Name)
OK State Line, Miss.
(Address)

(2) Location: NE 1/4, SW 1/4, Sec 20 T. 6 R. 6
15 miles S, of Waynesboro
(distance) (direction) (Nearest Town)

(3) Topography: flat
(Hilly) (Flat) (Level)

(4) Purpose of Well: domestic
(Domestic Irrigation
Municipal, Industrial, Other)

Description & Color of Materials Sand, Clay, Red Clay, Shell, etc.	Thick- ness Feet	Depth Feet
red clay	8	8
sand	5	13
blue chalk	97	110
chalk to fine sand	15	125
course sand	1	126
fine sand & chalk	69	195
med course sand	2	197
white chalk	10	207
rock	2	209
white chalk	56	265
med to med course sand	33	298
stopped on Chalk		

Information upon completion of well:

(1) Diameter 2" ~~2 1/8~~ inches.

(2) Total Depth 298' feet.

(3) Water Level 29' feet below top of ground.

(4) Cased to 273', Size 2"


(5) Screen: Size 1/4", Length 10'
5' 7" slot on bottom 5' 6" slot on top 1 1/2" gap

(6) Were any formations sealed against pollution?
yes, no.

If YES depth of formation _____

Why _____

Drillers Remarks: _____

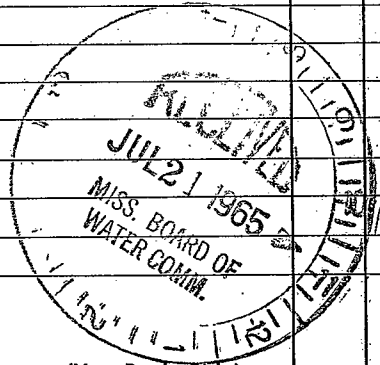

(Use Back Side)

Well No.

