

Wayne
Y13
2-67

MISSISSIPPI
BOARD OF WATER COMMISSIONERS
416 North State Street
Jackson, Mississippi 39201

WATER WELL DRILLERS LOG

Feb. 15, 1967 date well completed Porter Drilling, Inc. firm name Wayne county well located

LANDOWNER: County Line Baptist Church
Box 1 State Line Miss
(mailing address)

WELL LOCATION:
sec 33 T 6 N R 6 E
S W
7 miles west of State Line
(distance) (direction) (nearest town)

description of formations encountered	from	to
sandy clay	0	10
sand	10	30
sand & chalk	30	43
chalk	43	85
sand	85	90
chck	90	92

WELL PURPOSE: home
(home, irrigation, municipal, industrial)

WELL COMPLETION DATA:

(1) diameter (inches) 2"

(2) total depth (feet) 92'

(3) static water level (feet) 62 below above top of ground.

(4) casing galv. steel, 94'
(material) (depth)
2" if telescope see back.
(size)


(5) screen 5', 86'
(length) (depth to top)
1 1/4", S.S.
(size) (material)

(6) pump 1, 5
(HP) (yield gpm)
elec
(type power)

(7) electric log no
(yes or no)
(organization running log)


(8) how well bottom plugged
1 1/4" plug

DRILLERS REMARKS:

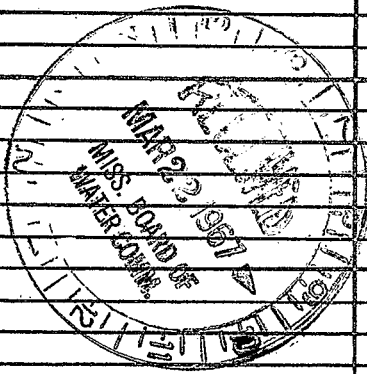

If well telescopes please sketch and show depths.

GROUND LEVEL

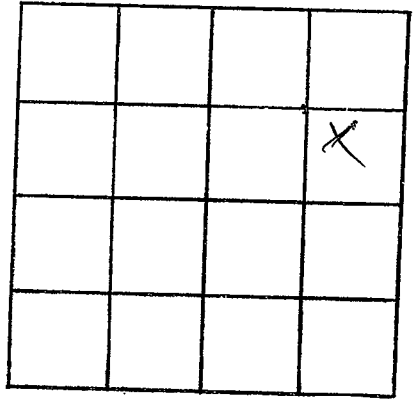

SECTION 33

Please indicate well location X.

ADDITIONAL INFORMATION

If more than one screen,
show locations of each on sketch.