

WAYNE
Y 14

MISSISSIPPI BOARD OF WATER COMMISSIONERS

7-10-62

WATER WELL DRILLERS LOG

Date: July 10, 1962 Driller: Porter Drilling & Sup. County Wayne
(Name)

	Description & Color of Materials Sand, Clay, Red Clay, Shell, etc.	Thick- ness Feet	Depth Feet
(1) Owner of Land: <u>Wade Hamilton</u> (Name) <u>At 1 State Line, Miss.</u> (Address)	sandy clay	20	20
	white chalk	20	40
	blue chalk	105	145
(2) Location: <u>SW 1/4, SW 1/4, Sec. 27 T6R6</u>	fine sand	10	155
<u>7</u> miles <u>west</u> , of <u>State Line</u> (distance) (direction) (Nearest Town)	blue chalk	30	185
	fine sand	25	210
(3) Topography: <u>Hilly</u> (Hilly) (Flat) (Level)	blue chalk	2	212
	fine sand	53	265
(4) Purpose of Well: <u>Domestic</u> (Domestic Irrigation Municipal, Industrial, Other)	Chalk & streaks of sand	50	315
	course sand	6	321
	blue chalk	12	333

Information upon completion of well:


- (1) Diameter 2" inches.
- (2) Total Depth 321 feet.
- (3) Water Level 110 feet below top of ground.
- (4) Cased to 315, Size 2"
- (5) Screen: Size 1/4", Length 6'
- (6) Were any formations sealed against pollution?

 yes, no.

If YES depth of formation _____

Why _____

Drillers Remarks: _____

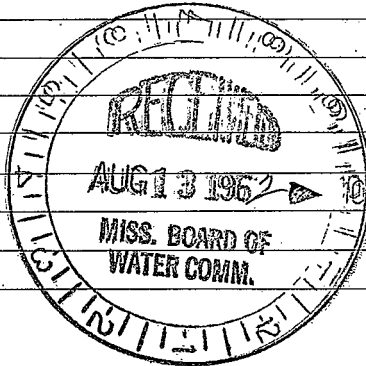

(Use Back Side)

Well No.

