

Wayne  
 Y16  
 11-67

MISSISSIPPI  
 BOARD OF WATER COMMISSIONERS  
 416 North State Street  
 Jackson, Mississippi 39201

WATER WELL DRILLERS LOG

Nov 29 1967 Porter Drilling & Sps Wayne  
 date well completed firm name county well located


LANDOWNER: Ray Dunn  
Rt 1 State Line  
 (mailing address)  
 WELL LOCATION:  
 sec. 19 T. 9 N. R. 6 E.  
15 miles S of Waynesboro  
 (distance) (direction) (nearest town)

description of formations encountered	from	to
<u>red clay</u>	<u>0</u>	<u>12</u>
<u>red chalk</u>	<u>12</u>	<u>20</u>
<u>blue chalk</u>	<u>20</u>	<u>75</u>
<u>red sand</u>	<u>75</u>	<u>79</u>
<u>course sand</u>	<u>79</u>	<u>86</u>
<u>stayed white steel in sand</u>		

WELL PURPOSE: home  
 (home, irrigation, municipal, industrial)


WELL COMPLETION DATA:  
 (1) diameter (inches) 2"  
 (2) total depth (feet) 86'  
 (3) static water level (feet) 62 below above top of ground.  
 (4) casing steel, 77' (material) (depth)  
2" if telescope see back. (size)  
 (5) screen 6', 30 (length) (depth to top)  
1/4", 60 galvanized jacket (size) (material)  
 (6) pump 3/4, 6 (HP) (yield gpm)  
elec (type power)  
 (7) electric log no (yes or no)  
 (organization running log)  
 (8) how well bottom plugged flush point

DRILLERS REMARKS:

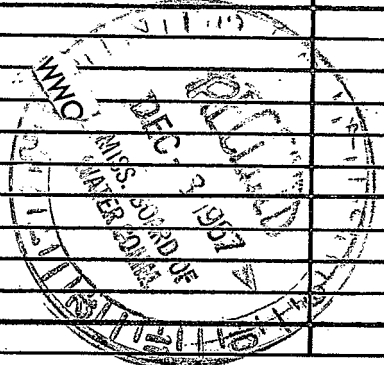

If well telescopes please sketch and show depths.

GROUND LEVEL

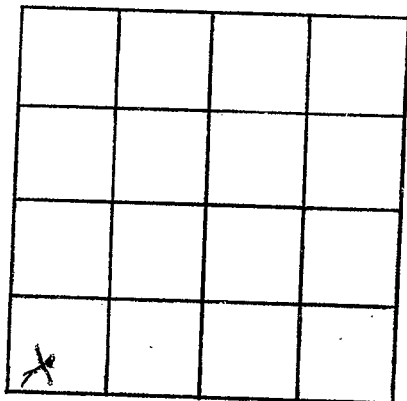

SECTION 19

Please indicate well location X.

ADDITIONAL INFORMATION

If more than one screen,  
show locations of each on sketch.