

Returned for info
3/21/69
CODED

MISSISSIPPI
BOARD OF WATER COMMISSIONERS
416 North State Street
Jackson, Mississippi 39201

WATER WELL DRILLERS LOG

Wayne
Y 17
2-69

2-20-1969 date well completed
Lorton Well Service firm name
Wayne county well located

LANDOWNER: Norman Regner
State Line, Miss
39362
(mailing address)

description of formations encountered	from	to
<u>Sandy Clay</u>	<u>0</u>	<u>50</u>
<u>Clay</u>	<u>50</u>	<u>70</u>
<u>Streaks of Sand</u>	<u>70</u>	<u>110</u>
<u>Clay Sand streaks</u>	<u>110</u>	<u>175</u>

WELL LOCATION:
sec. 9 T. 6 S. R. 6 E.
6 miles SW of Chicora
(distance) (direction) (nearest town)

WELL PURPOSE: Home
(home, irrigation, municipal, industrial)

WELL COMPLETION DATA:

- (1) diameter (inches) 2 in.
- (2) total depth (feet) 175 ft.
- (3) static water level (feet) 70 below above top of ground.
- (4) casing 2 in. 170
(material) (depth)
- (size) if telescope see back.
- (5) screen 20 ft. 170 ft.
(length) (depth to top)
- 2 in. 2 in. Galv.
(size) (material)
- (6) pump 3/4 6 G.P.M.
(HP) (yield gpm)
- (type power)
- (7) electric log _____
(yes or no)
- (organization running log)
- (8) how well bottom plugged Value

DRILLERS REMARKS:


CODED

MAR 21 1969

MISS. BD. OF
WATER COMMISSIONERS

If well telescopes please sketch and show depths.

GROUND LEVEL

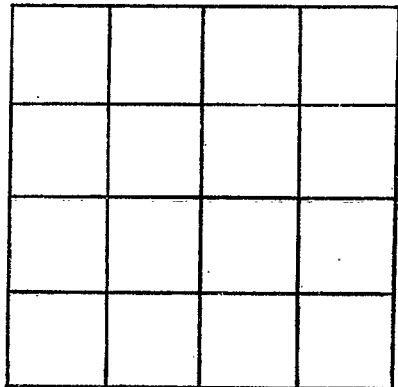

SECTION _____

Please indicate well location X.

ADDITIONAL INFORMATION

If more than one screen, show locations of each on sketch.