

Wayne
 Y 18
 9-69

MISSISSIPPI
 BOARD OF WATER COMMISSIONERS
 416 North State Street
 Jackson, Mississippi 39201

CODED

WATER WELL DRILLERS LOG

Paul D. Dillingham, Jr.

date well completed 19 69 firm name Wayne county well located Wayne


LANDOWNER: <u>Edward</u>	description of formations encountered	from	to
<u>Deerman</u>	<u>red clay</u>	<u>0</u>	<u>5</u>
<u>211 Buckatuna Miss</u> (mailing address)	<u>sand & chalk</u>	<u>5</u>	<u>20</u>
WELL LOCATION:	<u>chalk</u>	<u>20</u>	<u>32</u>
sec. <u>11</u> T <u>60</u> N R <u>6</u> E	<u>work strata</u>	<u>42</u>	<u>44</u>
3 miles SW of <u>Buckatuna</u>	<u>sand & chalk</u>	<u>44</u>	<u>67</u>
(distance) (direction) (nearest town)	<u>chalk</u>	<u>68</u>	<u>72</u>
WELL PURPOSE: <u>drinking water</u> (home, irrigation, municipal, industrial)	<u>lime sand</u>	<u>72</u>	<u>79</u>
WELL COMPLETION DATA:	<u>shell course sand</u>	<u>79</u>	<u>89</u>
(1) diameter (inches) <u>4"</u>	<u>chalk</u>	<u>89</u>	<u>90</u>
(2) total depth (feet) <u>90'</u>	<u>lime sand</u>		
(3) static water level (feet) <u>53'</u> below top of ground.	<u>red clay</u>		
(4) casing <u>steel</u> <u>20'</u> (material) (depth)	<u>of sand</u>		
<u>1 1/2"</u> (size) if telescope see back.	<u>10' 2 1/2" ss. packed</u>		
(5) screen <u>10'</u> <u>80'</u> (length) (depth to top)	<u>with 1' 2 1/2" log pipe</u>		
<u>2 1/2"</u> (size) <u>20' 1 S.S.</u> (material)	<u>throat on well with rubber packer</u>		
(6) pump <u>1/2</u> <u>30</u> (HP) (yield gpm)	<u>24' 1 1/4" clay pipe</u>		
<u>elec.</u> (type power)			
(7) electric log <u>no</u> (yes or no)			
(organization running log)			
(8) how well bottom plugged			
DRILLERS REMARKS:			

SEP 17 1969

MISS. BD. OF
 WATER COM.

If well telescopes please sketch and show depths.

GROUND LEVEL

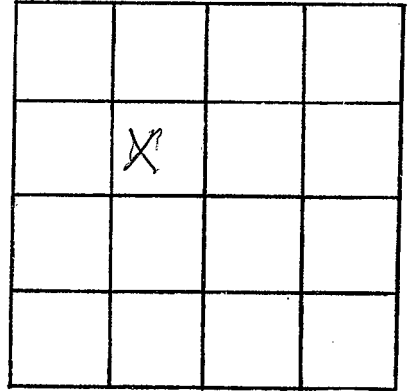

SECTION 11

Please indicate well location X.

ADDITIONAL INFORMATION

If more than one screen,
show locations of each on sketch.