

WAYNE

Y 19

7-29-70

MISSISSIPPI BOARD OF WATER COMMISSIONERS 416 North State Street Jackson, Mississippi 39201

CODED

WATER WELL DRILLERS LOG

July 29 1970 (date well completed) Delta Drilling, Inc. (firm name) Wayne (county well located)

LANDOWNER: James Dunn

description of formations encountered

from

to

411 State Line (mailing address)

red clay 0 5
mineral chert 5 21
blue chalk 27 94
sand 94 103
stagnation chalk

WELL LOCATION:

sec. 19 T 6 N R 6 E S 14 miles S of (nearest town) Wayne

WELL PURPOSE: Sanitation (home, irrigation, municipal, industrial)

WELL COMPLETION DATA:

- (1) diameter (inches) 2
(2) total depth (feet) 103
(3) static water level (feet) 91 below top of ground
(4) casing steel 95 (material) (depth)
(5) screen 6 length 97 (depth to top)
(6) pump 1/2 (HP) 8 1/2 (yield gpm) elec. (type power)
(7) electric log no (yes or no)

6' 1 1/4" 80 ga SS with 3' 1/4" log pipe bent 1 m with gaslar 91' 1 1/4" log pipe

CODED

(organization running log)


(8) how well bottom plugged sand point

DRILLERS REMARKS:

AUG 13 1970

If well telescopes please sketch and show depths.

GROUND LEVEL

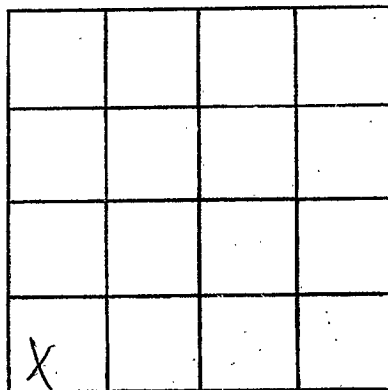

SECTION 19

Please indicate well location X.

ADDITIONAL INFORMATION

If more than one screen,
show locations of each on sketch.