

WAYNE
Y 20
2-71

MISSISSIPPI
BOARD OF WATER COMMISSIONERS
416 North State Street
Jackson, Mississippi 39201

CODED

WATER WELL DRILLERS LOG

Feb 1971 date well completed
Peeples Drilling Co. firm name
Wayne county well located

LANDOWNER: Charles E. Kittrell
R.F.D.
State Line, Miss.
(mailing address)

description of formations encountered	from	to
Yellow Sandy clay	0	10
Yellow sand & gravel	10	17
White clay	17	58
Yellow sand	58	104
White clay & sand streaks	104	147
White & Blue clay	147	198
White sand	198	231
White sandy clay	231	252
Hard White & Blue clay	252	336
White clay & small sand streaks	336	370
Multi-colored sand	370	382

WELL LOCATION:
sec. 35 T 6N S R 6 E W
5 miles W of State Line
(distance) (direction) (nearest town)

WELL PURPOSE: HOME
(home, irrigation, municipal, industrial)

- WELL COMPLETION DATA:
- (1) diameter (inches) 2"
 - (2) total depth (feet) 382'
 - (3) static water level (feet) 2.3 below top of ground. ~~above~~
 - (4) casing Galv. 387 (material) (depth)
2" (size) if telescope see back.
 - (5) screen 5' 377' (length) (depth to top)
2" stainless (size) (material)
 - (6) pump NONE (HP) (yield gpm)
(type power)
 - (7) electric log no (yes or no)
(organization running log)
 - (8) how well bottom plugged Back
wash valve

CODED


MAR 9 - 1971

MISS. RD. OF
WATER COMM.

DRILLERS REMARKS:

If well telescopes please sketch and show depths.

GROUND LEVEL

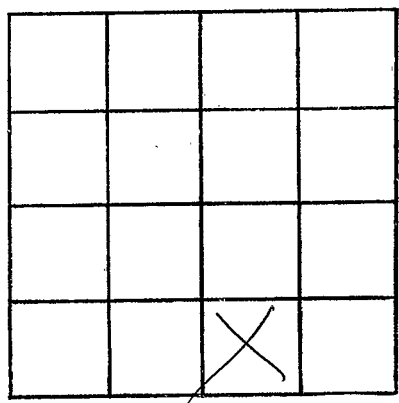

SECTION 35

Please indicate well location X.

ADDITIONAL INFORMATION

Lined area for additional information.

If more than one screen, show locations of each on sketch.