

**WAYNE**  
**Y 23**  
**5-31-72**

MISSISSIPPI  
 BOARD OF WATER COMMISSIONERS  
 416 North State Street  
 Jackson, Mississippi 39201

**CODED**

**WATER WELL DRILLERS LOG**

5/31 1972 CARRS well service WAYNE  
 date well completed firm name county well located


LANDOWNER: <u>O.C. Henderson</u>	description of formations encountered	from	to
<u>RA1 Bucaterra, Miss</u>	<u>TOP Soil</u>	<u>0</u>	<u>1</u>
	<u>yellow CLAY</u>	<u>1</u>	<u>14</u>
(mailing address)	<u>yellow + white CLAY</u>	<u>14</u>	<u>27</u>
	<u>Fine BROWN S.D. + ROCK</u>	<u>27</u>	<u>30</u>
WELL LOCATION:	<u>Bluish CLAY</u>	<u>30</u>	<u>33</u>
sec. <u>20</u> T. <u>6N</u> S. R. <u>6E</u> W. <u>W</u>	<u>DARK BLUE CLAY</u>	<u>33</u>	<u>65</u>
<u>7 1/2</u> miles <u>SSW</u> of <u>BUC</u>	<u>GRAY CLAY</u>	<u>65</u>	<u>72</u>
(distance) (direction) (nearest town)	<u>Fine SAND</u>	<u>72</u>	<u>73</u>
	<u>Bluish CLAY</u>	<u>73</u>	<u>83</u>
WELL PURPOSE: <u>HAMP</u>	<u>Fine Fine SAND</u>	<u>83</u>	<u>86</u>
(home, irrigation, municipal, industrial)	<u>Bluish CLAY</u>	<u>86</u>	<u>90</u>
WELL COMPLETION DATA:	<u>Fine SAND</u>	<u>90</u>	<u>91</u>
(1) diameter (inches) <u>4 1/2 x 2"</u>	<u>Bluish CLAY</u>	<u>91</u>	<u>93</u>
(2) total depth (feet) <u>222</u>	<u>Fine fine white SAND</u>	<u>93</u>	<u>98</u>
(3) static water level (feet) <u>73</u> (below/above top of ground)	<u>Fine white SAND</u>	<u>98</u>	<u>105</u>
(4) casing <u>Iron</u> (material) <u>210</u> (depth)	<u>Med white SAND</u>	<u>105</u>	<u>108</u>
(size) If telescope see back.	<u>Blue CLAY</u>	<u>108</u>	<u>143</u>
(5) screen <u>10'</u> (length) <u>210'</u> (depth to top)	<u>Fine white SAND</u>	<u>143</u>	<u>207</u>
<u>1/4</u> (size) <u>STAINLESS STEEL</u> (material)	<u>Med white SAND</u>	<u>207</u>	<u>222</u>
(6) pump <u>1</u> (HP) <u>8</u> (yield gpm)			
<u>ELECT</u> (type power)			
(7) electric log <u>NO</u> (yes or no)			
(organization running log)			
(8) how well bottom plugged <u>1/4 B.W.V.</u>			
DRILLERS REMARKS: <u>Still in S.D</u>			
<u>Whom qui? DRILLING -</u>			
<u>Tested well @ 8 P.M.</u>			

JUN - 6 1972

MISS. Bd. of  
 WATER COMMISSIONERS

If well telescopes please sketch and show depths.

GROUND LEVEL

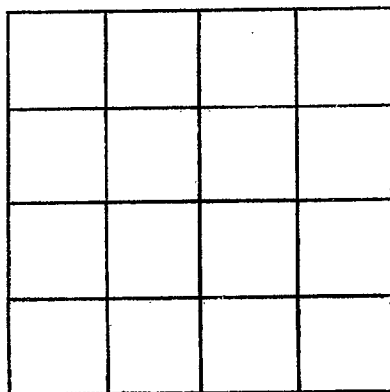

SECTION \_\_\_\_\_

Please indicate well location X.

ADDITIONAL INFORMATION

If more than one screen,  
show locations of each on sketch.