

WAYNE
Y 24
3-23-75

MISSISSIPPI
BOARD OF WATER COMMISSIONERS
416 North State Street
Jackson, Mississippi 39201

CODED

WATER WELL DRILLERS LOG

March 23 1972 Proctor Drilling & Log Wayne
date well completed firm name county well located

LANDOWNER: Reel Jones
Box 1 State Line Miss
(mailing address)

description of formations encountered	from	to
red clay	0	25
red sand	25	40
blue chalk		
will streak up		
fine sand	40	200
loam - brown sand	200	220
light multiple silty		
red sand		

WELL LOCATION:
sec 20 T 6 N R 6 E
6 miles SW Buckatun of W
(distance) (direction) (nearest town)

WELL PURPOSE: none
(home, irrigation, municipal, industrial)

WELL COMPLETION DATA:
(1) diameter (inches) 2"
(2) total depth (feet) 220'
(3) static water level (feet) 72 (below/above top of ground)
(4) casing steel 213'
(material) (depth)
2" if telescope see back.
(size)
(5) screen 5' 215'
(length) (depth to top)
1/4" bedrock ss.
(size) (material)
(6) pump 1 8
(HP) (yield gpm)
elec.
(type power)
(7) electric log no
(yes or no)
(organization running log)

84' 1 1/4" drag pipe
5' 1 1/2" bedrock ss.
with 4' 1 1/4" logs
tract in with packer

CODED


MAY 1 1972

(8) how well bottom plugged:
flush ground

DRILLERS REMARKS:

If well telescopes please sketch and show depths.

GROUND LEVEL

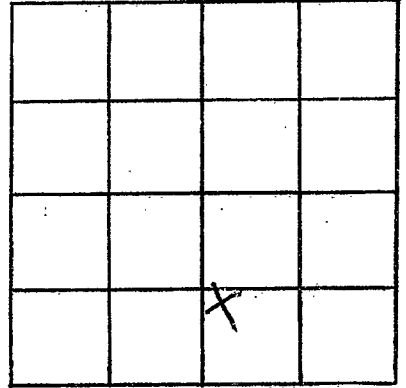

SECTION 20

Please indicate well location X.

ADDITIONAL INFORMATION

If more than one screen,
show locations of each on sketch.