

WAYNE

Y27

7-27-73

MISSISSIPPI BOARD OF WATER COMMISSIONERS 416 North State Street Jackson, Mississippi 39201

CODED

WATER WELL DRILLERS LOG

July 27 1973 date well completed

Boys Drilling Log firm name

Wayne county well located

LANDOWNER: Frank Blaine

description of formations encountered from to

All Buckatunna (mailing address)

Table with 3 columns: description of formations encountered, from, to. Rows include: red sandy clay (0-3), brown loess (3-18), red chalk (18-38), blue chalk (38-45), red chalk (45-60), blue chalk (60-90), fine sand + chalk (90-109), blue chalk (109-129), grey sand + chalk (129-138), blue chalk (138-154), red sand (154-161), depend on blue chalk.

WELL LOCATION: sec. 16 T. 60 N. R. 6 E. S. 5 miles S.W. of Buckatunna (distance) (direction) (nearest town)

WELL PURPOSE: chicken (home, irrigation, municipal, industrial)

WELL COMPLETION DATA:

- (1) diameter (inches) 2'
(2) total depth (feet) 161
(3) static water level (feet) 75 below top of ground
(4) casing steel 155' (material) (depth) 2' (size) if telescope see back.
(5) screen 5' 156 (length) (depth to top) 1/4 inch, galv S.S. (size) (material)
(6) pump 1 (HP) 10 (yield gpm) elec. (type power)
(7) electric log no (yes or no)

5 CODED chert 5' with 18" 1 1/2" drop pipe head in with packer 84' 1 1/2" drop pipe


(organization running log)

(8) how well bottom plugged flush ground

DRILLERS REMARKS:

If well telescopes please sketch and show depths.

GROUND LEVEL

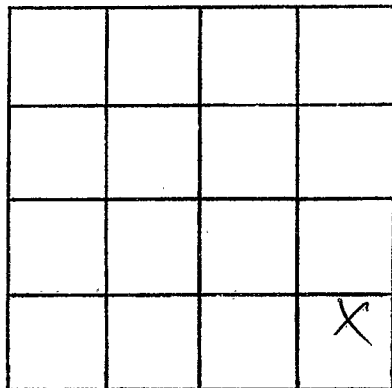

SECTION 16

Please indicate well location X.

ADDITIONAL INFORMATION

If more than one screen,
show locations of each on sketch.