

**WAYNE**  
**Y28**  
**10-29-73**

MISSISSIPPI  
 BOARD OF WATER COMMISSIONERS  
 416 North State Street  
 Jackson, Mississippi 39201

**WATER WELL DRILLERS LOG**

10-29-73 CARRS well service WAYNE  
 date well completed firm name county well located

LANDOWNER: Willie G. Moulard  
 BUCATUNNA MISS  
 (mailing address)

WELL LOCATION:  
 sec. 13 T-6<sup>N</sup> R-6<sup>E</sup>  
 2 miles North of BUC  
 (distance) (direction) (nearest town)

description of formations encountered	from	to
Top Soil	0	1
Yellow sandy CLAY	1	3
Pink & white CLAY	3	12
Med white SAND	12	16
COARSE white SAND w/ G.R. & V.I.	16	32

WELL PURPOSE: HOME  
 (home, irrigation, municipal, industrial)

- WELL COMPLETION DATA:
- (1) diameter (inches) 2" x 4"
  - (2) total depth (feet) 32'
  - (3) static water level (feet) 20' below top of ground.
  - (4) casing PVC, 28' (material) (depth)
  - (size) if telescope see back.
  - (5) screen 4' length, 28' depth to top  
 2" PVC (slot) (size) (material)
  - (6) pump 1/2 HP, 10 (yield gpm)  
 Elect (type power)
  - (7) electric log No (yes or no)
  - (organization running log)
  - (8) how well bottom plugged 2 B.W.V.


**CODED**

NOV 5 1973

DRILLERS REMARKS: still in sand when p.u. 7

If well telescopes please sketch and show depths.

GROUND LEVEL

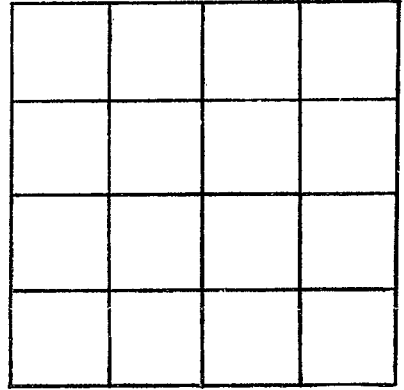

SECTION \_\_\_\_\_

Please indicate well location X.

ADDITIONAL INFORMATION

If more than one screen,  
show locations of each on sketch.