

**WAYNE**  
**Y29**  
**1-9-74**

MISSISSIPPI  
 BOARD OF WATER COMMISSIONERS  
 416 North State Street  
 Jackson, Mississippi 39201

CODED

WATER WELL DRILLERS LOG

1-9-74 19 74 CARRS well SERV firm name WAYNE county well located

LANDOWNER: JAMES FRANKS  
BUCATUNNA MISS  
 (mailing address)


| description of formations encountered | from | to |
|---------------------------------------|------|----|
| Top Soil                              | 0    | 2  |
| Redish SAND                           | 2    | 10 |
| Med yellow SAND                       | 10   | 14 |
| Med white SAND                        | 14   | 18 |
| COARSE white SAND                     | 18   | 22 |
| PEARL GRAVEL                          | 22   | 30 |
| BLUE CLAY                             | 30   | 1  |

WELL LOCATION:  
 sec. 6 T. 60 S. R. 6 E. W  
1/4 miles South of BUC  
 (distance) (direction) (nearest town)

WELL PURPOSE: HOME  
 (home, irrigation, municipal, industrial)

- WELL COMPLETION DATA:
- (1) diameter (inches) 2"
  - (2) total depth (feet) 30
  - (3) static water level (feet) 10' <sup>below</sup> / <sub>above</sub> top of ground.
  - (4) casing PVC, 25'  
 (material) (depth)  
 (size) If telescope see back.
  - (5) screen 5', 25'  
 (length) (depth to top)  
1/4", PVC 10 Slot  
 (size) (material)
  - (6) pump 3/4, 8  
 (HP) (yield gpm)  
ELECT  
 (type power)
  - (7) electric log No  
 (yes or no)  
 (organization running log)
  - (8) how well bottom plugged Built with paint

CODED

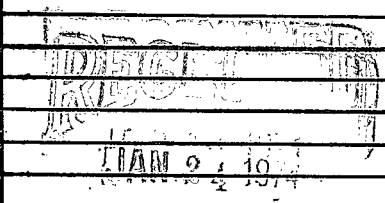


DRILLERS REMARKS:

MISSISSIPPI BOARD OF WATER COMMISSIONERS

If well telescopes please sketch and show depths.

GROUND LEVEL

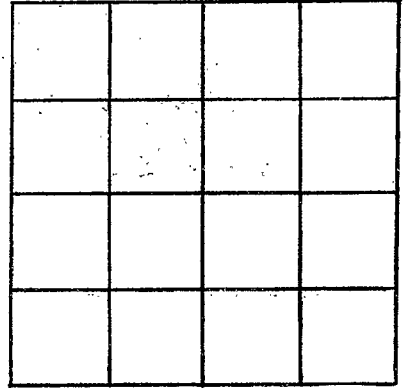

SECTION \_\_\_\_\_

Please indicate well location X.

ADDITIONAL INFORMATION

If more than one screen,  
show locations of each on sketch.