

WAYNE

Y 30

7-19-74

MISSISSIPPI BOARD OF WATER COMMISSIONERS  
416 North State Street  
Jackson, Mississippi 39201

CODED

WATER WELL DRILLERS LOG

July 19 1974 Boyer Drilling Wayne  
date well completed firm name county well located

LANDOWNER: Carl Bennett  
1930 Le Jeune Dr  
Mobile Ala.  
(mailing address)

WELL LOCATION:  
sec 15 T 6 N R 6 E  
1 miles SW of Ruckatunnus  
(distance) (direction) (nearest town)

WELL PURPOSE: Home  
(home, irrigation, municipal, industrial)

- WELL COMPLETION DATA:
- (1) diameter (inches) 2"
  - (2) total depth (feet) 244'
  - (3) static water level (feet) 17' <sup>below</sup> <sub>above</sub> top of ground.
  - (4) casing P.V.C. 239'  
(material) (depth)  
2" if telescope see back.  
(size)
  - (5) screen 5' 239'  
(length) (depth to top)  
1 1/4" 6 slot S.S.  
(size) (material)
  - (6) pump 1 15  
(HP) (yield gpm)  
elec.  
(type power)
  - (7) electric log no  
(yes or no)
- (organization running log)
- (8) how well bottom plugged back wash valve

description of formations encountered	from	to
sand	0	15
chalk	15	42
chalky sand	42	54
chalk	54	90
chalky sand	90	112
chalk	112	143
chalky sand	143	193
chalk	193	199
sand	199	204
chalk	204	207
nut course sand	207	244
stayed white steel		
in hand		


5' 1 1/4" 6 slot S.S.  
screen screwed on  
end of casing with  
back wash valve on  
end & steel trap above  
42' 1" P.V.C. drop pipe

RECEIVED  
SEP 11 1974

DRILLERS REMARKS:

If well telescopes please sketch and show depths.

GROUND LEVEL

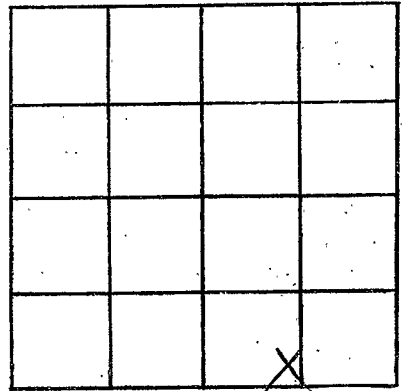

SECTION 15

Please indicate well location X.

ADDITIONAL INFORMATION

If more than one screen,  
show locations of each on sketch.