

MISSISSIPPI DEPARTMENT OF NATURAL RESOURCES
Bureau of Land and Water Resources
 Southport Mall
 P.O. Box 10631
 Jackson, Mississippi 39209
WATER WELL DRILLERS LOG

WAYNE
Y 32

CODED

6 18 1984 Carroll Well Service, Wayne county well located
 date well completed firm name

LANDOWNER: EW DOUGLAS
RT
State Line, Ms.
 (mailing address)

WELL LOCATION:
 sec. 22 T. 6 N. R. 6 E. S. 5 W. 7
 (distance) miles (direction) of STATELINE (nearest town)

WELL PURPOSE: HOME
 (home, irrigation, municipal, industrial)

WELL COMPLETION DATA:

(1) diameter (inches) 4 1/2

(2) total depth (feet) 180

(3) static water level (feet) 14 below top of ground. (above)

(4) casing PVC, 180 (material), (depth)

_____ if telescope see back. (size)

(5) screen 10', 170 (length), (depth to top)

8", PVC (size), (material)

(6) pump _____ (HP), _____ (yield gpm)

_____ (type power)

(7) electric log _____ (yes or no)

_____ (organization running log)

(8) how well bottom plugged cap

description of formations encountered	from	to
TOP SOIL	0	1
gray clay	1	10
W coarse	10	27
gray sand	27	45
gray clay	45	50
gray clay & sand	50	65
coarse gray SD	65	80
gray clay A SD	80	100
gray clay	100	130
coarse gray SD	130	150
coarse SD	150	170
coarse brown SD	170	175
gray clay	175	210
gray clay A SD	210	215
gray SD	215	219
gray SD	219	235
coarse white SD	235	280

CODED


DEPT. OF NATURAL RESOURCES
 BUREAU OF LAND & WATER RESOURCES

JUN 25 1984
RECEIVED

DRILLERS REMARKS:

If well telescopes please sketch and show depths.

GROUND LEVEL

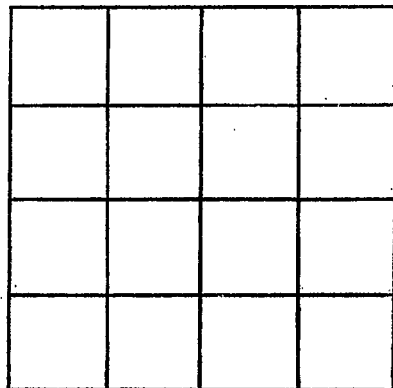

SECTION _____

Please indicate well location X.

ADDITIONAL INFORMATION

If more than one screen,
show locations of each on sketch.