

MISSISSIPPI DEPARTMENT OF NATURAL RESOURCES

Bureau of Land and Water Resources

Southport Mall

P.O. Box 10631

Jackson, Mississippi 39209

WATER WELL DRILLERS LOG

CODED

WAYNE
Y 34

July 23 1981 date well completed
Robert Drilling & Log firm name
Wayne county well located

LANDOWNER: Alton Guy
At 1 State Line, Ms.

description of formations encountered	from	to
	red clay	0

(mailing address)

blue clay	3.5	9.5
clay sand sand	9.5	120

WELL LOCATION:
sec 32 T 6 N R 6 E
9 miles S of Clivora (distance) (direction) (nearest town)

clay	120	175
sand	175	180
clay	180	206
fine fine sand	206	234

WELL PURPOSE: Home (home, irrigation, municipal, industrial)

well sand some clay	234	258
clay & sand	258	280
fine fine sand	280	300

WELL COMPLETION DATA:

clay & sand	300	305
fine fine sand	305	319
clay	319	350
fine fine sand	350	360

(1) diameter (inches) 2"

(2) total depth (feet) 510'

(3) static water level (feet) 136 (below top of ground)

(4) casing PVC 500' (material) (depth)

2" (size) If telescope see back.

(5) screen 10' 500' (length) (depth to top)

2" (size) belt S.S. (material)

(6) pump 2 (HP) 5 (yield gpm)

elec. (type power)

(7) electric log no (yes or no)

(organization running log)

(8) how well bottom plugged 2' sand slush

clay	305	319
clay	319	350
fine fine sand	350	360
clay some sand	360	368
clay	368	489
hard sand some clay	489	493
fine most clean sand	493	500
lined cone to cone		
fine sand	500	510
bluish white silty		
oil sand		

147' # 20 1/4" P.V.C. down pipe

CODED

DEPT. OF NATURAL RESOURCES
BUREAU OF LAND & WATER RESOURCES


AUG 6 1981

RECEIVED

DRILLERS REMARKS:

If well telescopes please sketch and show depths.

GROUND LEVEL

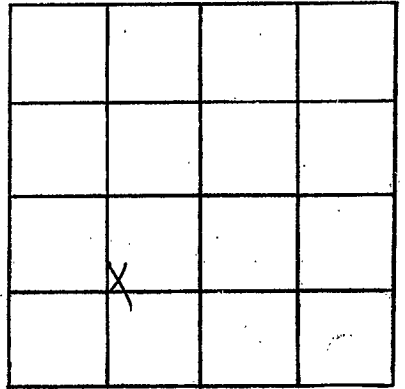

SECTION 32

Please indicate well location X.

ADDITIONAL INFORMATION

If more than one screen,
show locations of each on sketch.