

MISSISSIPPI DEPARTMENT OF NATURAL RESOURCES

Bureau of Land and Water Resources

COUNTY WELL LOCATED WAYNE	
WELL NUMBER 35	CODED <input checked="" type="checkbox"/>
DATE WELL COMPLETED 3/28/88	

PERMIT NUMBER 301
NAME OF DRILLING FIRM CARR'S WELL SER.
BUCKATUNNO, MS.

P.O. Box 10631
Jackson, Mississippi 39209
WATER WELL DRILLERS LOG

NAME & MAILING ADDRESS OF LANDOWNER MARCO DRILLING CO.			
SHREVEPORT, LA.			
WELL LOCATION: SEC	TOWNSHIP	RANGE	
30	6	6	
DISTANCE	DIRECTION	NEAREST TOWN	
8 Miles	WSW	of BUCKATUNNO	
OTHER LANDMARK			
WELL PURPOSE: Home, Irrigation, Municipal, <u>Industrial</u> , Fish Pond, etc.			

PUMP DATA		
PUMP TYPE (Circle One): Submersible, Turbine, Jet, Flowing Well, Other (Describe) _____		
POWER TYPE (Circle One): Electric, Tractor, Diesel, Gasoline, Butane, Other (Describe) AIR LIFT		
Pump Capacity (GPM)	No. of Stages	Setting Depth
		FT.
PUMP TEST		
Well yielded 70 GPM with		
a drawdown of _____ ft.		
after _____ hours of pumping		

WELL DATA		
Well Depth 375	Casing Diameter (In.) 4"	Casing Length (Ft.)
Type of Casing PVC	Hole Depth 375	Depth to Static Water Level
TYPE OF COMPLETION: (Circle One or More): Gravel Packed, Underreamed, Telescoped, <u>Natural Development</u> , Open Hole, Other		
Top of Lap Pipe or Reduction in Casing		
FEET IF TELESCOPED OR MORE THAN ONE SCREEN: USE BACK PAGE		

LOG DATA	
TYPE OF LOG RUN (Circle One): No Log Run, Electric, Gamma Ray, Density, Sonic, Neutron, Other (Describe) _____	
Name of Organization Running Log	

SCREEN DATA		
Diameter - Inches 4"	Length - Feet 40'	Slot Size - Inches 20
Screen Type PVC	Depth to Bottom - Feet 375	


GEOLOGIC DATA (Office Use Only)			
Surface Elev.	Geologic Unit	Unit Thickness	Depth to Top
Subs. SWL	date	Analysis	Aquifer Test
Driller's Remarks			
APR 28 1988			
Department of Natural Resources Bureau of Land & Water Resources			

DESCRIPTION OF FORMATIONS ENCOUNTERED	FROM	TO	FORMATIONS (Continued)	FROM	TO
CHALK	0	45	CLAY	238	241
CLAY + SD.	45	60	THIN ROCK	241	
CLAY	60	124	CLAY	241	255
FN. SD + CLAY	124	135	FN. SD.	255	267
MED TO CR. SAND	135	156	HD. THIN RK.	267	
" " FN. "	156	165	SD (THIN)	267	271
CHALK	165	201	CHALK	271	279
CLAY + SD.	201	205	ROCK	279	280
CLEAN FN. SD.	205	213	CHALK	280	298
BROKEN SD. + CLAY	213	225	MED. CR. SD.	298	311
SAND	225	228			

IF MORE SPACE IS NEEDED, USE BACK

If well telescopes please sketch and show depths.

GROUND LEVEL

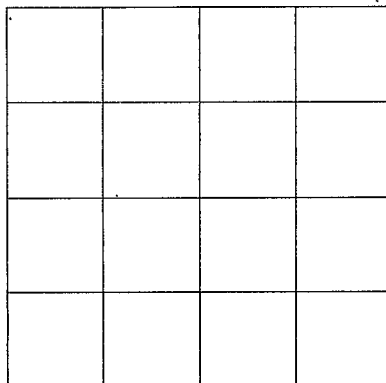

SECTION _____

Please indicate well location X.

ADDITIONAL INFORMATION

311-322 CIA
312-375 1600, 7-11-50

If more than one screen, show location of each on sketch.