

WAYNE
 Y 2000
 2-4-76

**MISSISSIPPI
 BOARD OF WATER COMMISSIONERS**
 416 North State Street
 Jackson, Mississippi 39201

WATER WELL DRILLERS LOG


Feb 4 1976 ¹³⁸ Port-Drillers & Log Wayne
 date well completed firm name county well located

LANDOWNER: <u>Tommy Williams</u>	description of formations encountered	from	to
<u>at 1 State Line Miss</u> (mailing address)	<u>rest clay & sand</u>	<u>0</u>	<u>43</u>
WELL LOCATION:	<u>rest clay</u>	<u>43</u>	<u>50</u>
sec <u>20</u> T <u>6</u> (N) R <u>6</u> E (W) <u>7</u> miles S.W. of <u>Buckhorn</u> (distance) (direction) (nearest town)	<u>blue clay</u>	<u>50</u>	<u>165</u>
WELL PURPOSE: <u>Home</u> (home, irrigation, municipal, industrial)	<u>thin 17 clay & shale</u>	<u>165</u>	<u>180</u>
WELL COMPLETION DATA:	<u>clay</u>	<u>180</u>	<u>207</u>
(1) diameter (inches) <u>2</u>	<u>hard sand</u>	<u>207</u>	<u>212</u>
(2) total depth (feet) <u>236</u>	<u>brown sand</u>	<u>212</u>	<u>236</u>
(3) static water level (feet) <u>63</u> below top of ground.	<u>stagnant water</u>		
(4) casing <u>P.V.C.</u> , <u>231</u> ' (material) (depth) <u>2</u> ' If telescope see back. (size)	<u>shell in sand</u>		
(5) screen <u>5</u> ' <u>231</u> ' (length) (depth to top) <u>1 1/2</u> " <u>brist SS</u> (size) (material)	<u>8 8" 1" P.V.C</u>	<u>large</u>	<u>large</u>
(6) pump <u>1</u> <u>12</u> (HP) (yield gpm) <u>elec</u> (type power)	<u>gauge</u>	<u>0</u>	<u>0</u>
(7) electric log <u>no</u> (yes or no)	<u>5 1 1/2" brist SS</u>		
(organization running log)	<u>secured on end of cas.</u>		
(8) how well bottom plugged <u>back wash valve</u>	<u>well track wash valve</u>		
DRILLERS REMARKS: _____	<u>on end & shell top</u>		
_____	<u>above</u>		

REGISTERED
 FEB 18 1976

If well telescopes please sketch and show depths.

GROUND LEVEL

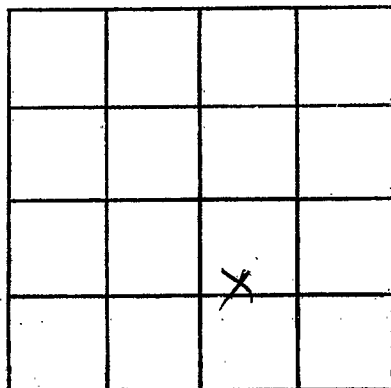

SECTION 20

Please indicate well location X.

ADDITIONAL INFORMATION

If more than one screen, show locations of each on sketch.