

WAYNE
Y 2001
9/13/76

MISSISSIPPI
 BOARD OF WATER COMMISSIONERS
 416 North State Street
 Jackson, Mississippi 39201

WATER WELL DRILLERS LOG


Sept. 13 1976 Porter Drilling & Log Wayne
 (date well completed) (firm name) (county well located)

LANDOWNER: <u>Ed Sumner Kellie</u>	description of formations encountered	from	to
<u>Rt 1 Box 80 State Line</u> (mailing address)	<u>clay</u>	<u>0</u>	<u>33</u>
WELL LOCATION: <u>33</u> sec <u>6</u> T <u>6</u> N <u>6</u> R <u>6</u> E <u>8</u> miles <u>W</u> of <u>State Line</u> (distance) (direction) (nearest town)	<u>clay fine sand</u>	<u>33</u>	<u>75</u>
WELL PURPOSE: <u>home</u> (home, irrigation, municipal, industrial)	<u>medium sand</u>	<u>75</u>	<u>83</u>
WELL COMPLETION DATA: (1) diameter (inches) <u>2"</u>	<u>clay & sand</u>	<u>83</u>	<u>87</u>
(2) total depth (feet) <u>82</u>	<u>clay</u>	<u>87</u>	<u>88</u>
(3) static water level (feet) <u>46</u> below top of ground.	<u>5' 1 1/4" 8 slot S.S.</u>		
(4) casing <u>P.V.C. 77'</u> (material) (depth)	<u>screen screwed on end</u>		
<u>2"</u> (size) if telescope see back.	<u>of cas. with back</u>		
(5) screen <u>5' 77'</u> (length) (depth to top)	<u>wash valve on end</u>		
<u>1 1/4"</u> (size) <u>8 slot S.S.</u> (material)	<u>to steel trap above</u>		
(6) pump <u>1</u> (HP) <u>10</u> (yield gpm)	<u>62' 1" P.V.C. drop pipe</u>		
<u>elec</u> (type power)			
(7) electric log <u>no</u> (yes or no)			
(organization running log)			
(8) how well bottom plugged <u>1/4" back wash valve</u>			
DRILLERS REMARKS:			

RECEIVED
 NOV - 3 1976

If well telescopes please sketch and show depths.

GROUND LEVEL

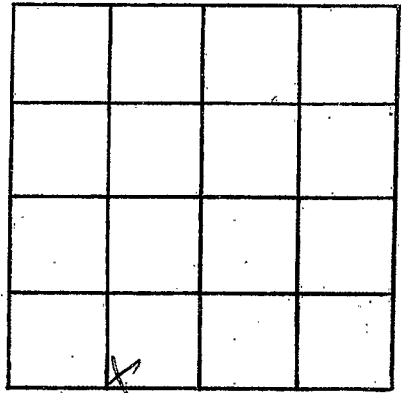

SECTION 33

Please indicate well location X.

ADDITIONAL INFORMATION

If more than one screen,
show locations of each on sketch.