

WAYNE  
2 2004  
2-1-77

MISSISSIPPI  
 BOARD OF WATER COMMISSIONERS  
 416 North State Street  
 Jackson, Mississippi 39201

WATER WELL DRILLERS LOG

Feb 1 1977 Porter Drilling & Log Wayne  
 date well completed firm name county well located

LANDOWNER: Kalle Joe  
Hutto

1314 Highland Dr. Mayrsville  
 (mailing address)

WELL LOCATION:  
 sec. 7 T. 60 N. R. 26 E. W  
3 miles (distance) of 3 (direction) of Buckatunna (nearest town)

WELL PURPOSE: camp  
 (home, irrigation, municipal, industrial)

WELL COMPLETION DATA:

- (1) diameter (inches) 2
- (2) total depth (feet) 242
- (3) static water level (feet) 16 below top of ground
- (4) casing PVC 232  
 (material) (depth)  
2" (size) If telescope see back.
- (5) screen 10' 232  
 (length) (depth to top)  
2" (size) 6 slot SS (material)
- (6) pump 3/4 10  
 (HP) (yield gpm)  
elec (type power) 60 gal flow
- (7) electric log no  
 (yes or no)
- (organization running log)
- (8) how well/bottom plugged back wash valve

DRILLERS REMARKS:

description of formations encountered	from	to
	Clay	0
sand	10	45
Clay	45	75
sand	75	85
Clay	85	190
med sand	190	225
med coarse sand	225	242
stimul white		
still in gravel		
10' 2" SS. 6 slot		
SS. screen with		
1 1/4" back wash valve		
on end of shell trays		
above		


**RECEIVED**

FEB - 7 1977

MISS. BD. OF WATER COMMISSIONERS

If well telescopes please sketch and show depths.

GROUND LEVEL

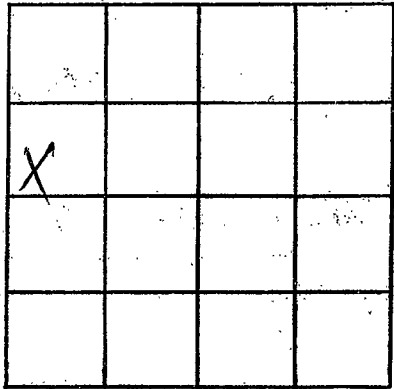

SECTION 7

Please indicate well location X.

ADDITIONAL INFORMATION

If more than one screen,  
show locations of each on sketch.