

WAYNE
 7/22/77
 1977

MISSISSIPPI
 BOARD OF WATER COMMISSIONERS
 416 North State Street
 Jackson, Mississippi 39201

WATER WELL DRILLERS LOG

7 1977 Cow's well Dr. Wayne
 date well completed firm name county well located

700
 Dec 13
 in this
 location

LANDOWNER: J.G. Jordan
 Rt. 1
 Bucktown, Ms.
 (mailing address)

WELL LOCATION:
 sec. 13 T-6 N R-5 E
 7 3/4 miles (distance) of Bucktown (nearest town)
 (direction)

WELL PURPOSE: home
 (home, irrigation, municipal, industrial)

- WELL COMPLETION DATA:
- (1) diameter (inches) 2"
 - (2) total depth (feet) 265
 - (3) static water level (feet) 230 below top of ground.
 - (4) casing P.V.C. 255 (material) (depth)
 2" (size) if telescope see back.
 - (5) screen 10' (length) 255' (depth to top)
 1 1/2" (size) 3-5 steel (material) 6 slot
 - (6) pump 20 (HP) (yield gpm)
 (type power)
 - (7) electric log NO (yes or no)
 (organization running log)
 - (8) how well bottom plugged 1 1/2" back wash


description of formations encountered	from	to
top soil	0	1
yel. sd.	1	10
yel. w. clay	10	15
cruse. w. sd.	15	30
w. yel. clay	30	45
sd. blue clay	45	58
bl. clay	58	70
y. bl. sd.	70	75
bluish clay	75	80
brown yel. & pk. clay	80	85
bl & pk. clay	85	125
y. w. sd.	125	140
cruse. w. sd.	140	155
hard bl. clay	155	220
sh. gray sd.	220	230
med. " "	230	240
cruse. " "	240	265
hd. bl. clay	265	270

RECEIVED
 JUL 29 1977
 MISS. BD. OF WATER COMMISSIONERS

DRILLERS REMARKS:

If well telescopes please sketch and show depths.

GROUND LEVEL

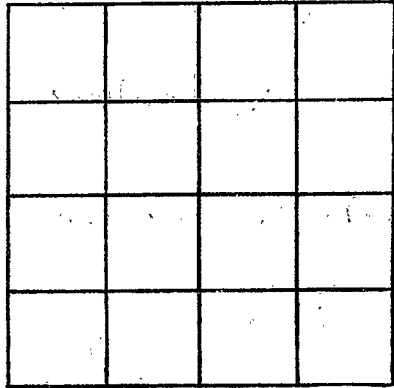

SECTION _____

Please indicate well location X.

ADDITIONAL INFORMATION

If more than one screen, show locations of each on sketch.