

WAYNE

Y 2007

2-21-78

MISSISSIPPI BOARD OF WATER COMMISSIONERS 416 North State Street Jackson, Mississippi 39201

WATER WELL DRILLERS LOG

2 21 78

date well completed

J.R. Green Water Well Drill

firm name

Wayne

county well located

LANDOWNER:

Ray Burke
R1 State Line mill.
(mailing address)

description of formations encountered

from

to

Red Clay	0	10
fine sand	10	10
white chalk	18	20
" "	20	20
fine sand	25	30
white chalk	30	35
sand	35	38
white chalk	38	40
" "	40	50
" "	50	55
sand	55	58
white chalk	58	60
" "	60	70
Red chalk	70	75
" "	75	80
" "	80	90
" "	90	98
fine sand	98	100
" "	100	105
BLUE CHALK	105	110
" "	110	120
" "	120	130
" "	130	134
Blue C. sand	134	135
Blue C. clay	135	140
" "	140	150
" "	150	152
fine sand	152	160
" "	160	170
" "	170	180

WELL LOCATION:

sec. 16 T. 16 N R. 6 E
6 S. Cheese, ms
(distance) (direction) (nearest town)

WELL PURPOSE:

(home, irrigation, municipal, industrial)

WELL COMPLETION DATA:

- (1) diameter (inches) 4"
- (2) total depth (feet) 180'
- (3) static water level (feet) 71 below top of ground
- (4) casing PVC 150 (material) (depth) if telescope see back. (size)
- (5) screen 15 150 (length) (depth to top) 2 1/2 x 008 PVC (size) (material)
- (6) pump 1 5 1/2 (HP) (yield gpm) 110 vac (type power)
- (7) electric log NO (yes or no)

(organization running log)

(8) how well bottom plugged


DRILLERS REMARKS:

RECEIVED JUN - 2 1978

MISS. BD. OF WATER COM.

If well telescopes please sketch and show depths.

GROUND LEVEL

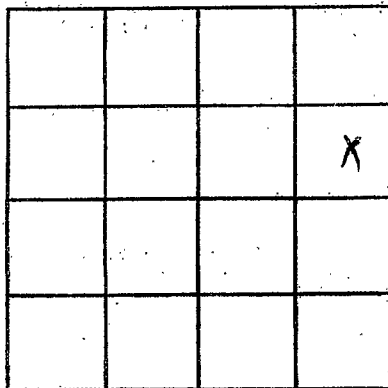

SECTION 10

Please indicate well location X.

ADDITIONAL INFORMATION

If more than one screen, show locations of each on sketch.