

WAYNE

Y 2010

9-7-78

MISSISSIPPI  
 BOARD OF WATER COMMISSIONERS  
 416 North State Street  
 Jackson, Mississippi 39201

WATER WELL DRILLERS LOG

Sept 7 1978 Porter Drilling Wayne  
 date well completed firm name county well located

LANDOWNER: Williams Albert

description of formations encountered

from to

Erill

PO Box 200000 Miss  
 (mailing address)

Clay 0 9  
sand 9 12  
Clay 12 30  
Clay & sand 30 45  
sand 45 51

WELL LOCATION:

sec. 3 T 6 N R 6 E  
 S W  
3 miles SW Beuchamp  
 (distance) (direction) of (nearest town)

stop on rock

WELL PURPOSE: home  
(home, irrigation, municipal, industrial)

WELL COMPLETION DATA:

42' 1" P.V.C. pipe

- (1) diameter (inches) 2"
- (2) total depth (feet) 51'
- (3) static water level (feet) 33' below top of ground.
- (4) casing PVC 46'  
(material) (depth)
- 2" if telescope see back.  
(size)
- (5) screen 5' 46'  
(length) (depth to top)
- 1/2" bsbt S.S.  
(size) (material)
- (6) pump 6  
(HP) (yield gpm)
- elec.  
(type power)
- (7) electric log no  
(yes or no)

(organization running log)

(8) how well bottom plugged 1/4" back wash valve


DRILLERS REMARKS:

**RECEIVED**  
**SEP 14 1978**

MISS. BB. OF WATER COMM

If well telescopes please sketch and show depths.

GROUND LEVEL

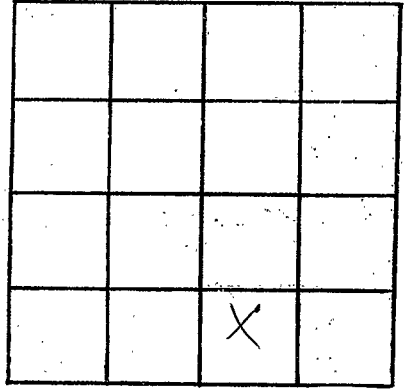

SECTION 3

Please indicate well location X.

ADDITIONAL INFORMATION

If more than one screen, show locations of each on sketch.