

WAYNE

Y 2011

8-26-78

MISSISSIPPI BOARD OF WATER COMMISSIONERS 416 North State Street Jackson, Mississippi 39201

WATER WELL DRILLERS LOG

Aug 26 1978 date well completed

78 Porter Drilling firm name

Itasca county well located

LANDOWNER: Mrs Deal

Erroll

description of formations encountered

from to

Box 1, Buckatanna, Miss (mailing address)

Clay	0	56
Clay with fine sand	56	65
Clay	65	165
med clay sand	165	174
Clay	174	195
sand	195	205
clay & sand	205	215
clay	215	267
sand	267	300
shaded white, still in sand		

WELL LOCATION:

sec 3 T 60 N R 6 E 3 miles SW Buckatanna (distance) (direction) (nearest town)

WELL PURPOSE: home (home, irrigation, municipal, industrial)

WELL COMPLETION DATA:

- (1) diameter (inches) 2"
- (2) total depth (feet) 300'
- (3) static water level (feet) 111' (below top of ground)
- (4) casing PVC 295' (material) (depth)
- (5) screen 2' (size) if telescope see back.
- (6) pump 3/4 HP 3 gal (HP) (yield gpm)
- (7) electric log no (yes or no)

147' 1 1/4" gal drop pipe

(organization running log)

(8) how well bottom plugged 2' back around valve


DRILLERS REMARKS:

RECEIVED SEP 14 1978

MISS. BD. OF WATER COMMISSIONERS

If well telescopes please sketch and show depths.

GROUND LEVEL

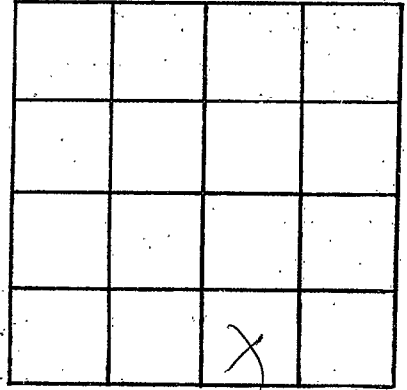

SECTION 3

Please indicate well location X.

ADDITIONAL INFORMATION

If more than one screen,
show locations of each on sketch.