


WAYNE
 Y 2012
 7-25-78

MISSISSIPPI
 BOARD OF WATER COMMISSIONERS
 416 North State Street
 Jackson, Mississippi 39201

WATER WELL DRILLERS LOG

July 25 1978 Proter Drilling Wayne
 date well completed firm name county well located

LANDOWNER: <u>Donald Glenn Henderson</u>	description of formations encountered	from	to
<u>At 1 State Line Miss</u> (mailing address)	clay	0	30
WELL LOCATION: sec <u>20</u> T <u>6</u> N R <u>6</u> E <u>5</u> miles SW of <u>Buckatun</u> (distance) (direction) (nearest town)	fine white sand	30	40
WELL PURPOSE: <u>home</u> (home, irrigation, municipal, industrial)	clay	40	165
WELL COMPLETION DATA:	clay & sand	165	190
(1) diameter (inches) <u>2'</u>	sand & clay	190	195
(2) total depth (feet) <u>333'</u>	sand	195	202
(3) static water level (feet) <u>43</u> (below/above top of ground)	clay	202	205
(4) casing <u>PVC</u> , <u>328</u> (material) (depth)	fine sand	205	212
<u>2'</u> (size) if telescope see back.	clay	212	227
(5) screen <u>5'</u> , <u>328</u> (length) (depth to top)	sand some clay	227	234
<u>2'</u> , <u>6 slot 55</u> (size) (material)	white sand some clay	234	300
(6) pump <u>1</u> (HP) <u>9</u> (yield gpm)	white sand	300	310
(7) electric log <u>no</u> (yes or no)	white fine sand	310	315
(8) how well bottom plugged <u>1/4" back wash valve</u>	liquid sand	315	325
DRILLERS REMARKS:	mottled fine sand	325	327
	stippled white steel in sand	327	345
	82' 1" P.V.C. deep pipe		

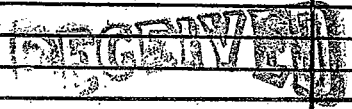


SEP 14 1978

MISSISSIPPI BOARD OF WATER COMMISSIONERS

If well telescopes please sketch and show depths.

GROUND LEVEL

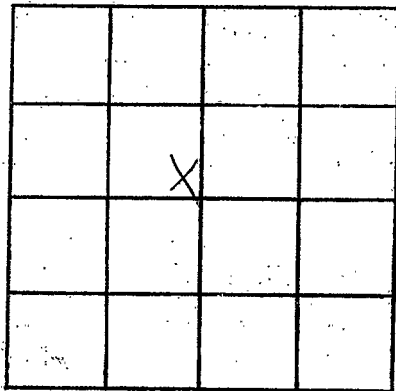

SECTION 20

Please indicate well location X.

ADDITIONAL INFORMATION

If more than one screen,
show locations of each on sketch.