

WAYNE

Y 2014

8-21-78

MISSISSIPPI BOARD OF WATER COMMISSIONERS 416 North State Street Jackson, Mississippi 39201

WATER WELL DRILLERS LOG McILWAIN WATER WELL SERVICE

August 21 1978 date well completed

RT. 2, BOX 37

WAYNESBORO, MISS. 39367

county well located


| LANDOWNER:   | description of formations encountered | from | to  |
|--|---------------------------------------|------|-----|
| Wayne Harrison<br>State Line, MS.<br>(mailing address)   |                                       |      |     |
| WELL LOCATION:<br>sec. 36 T. 6 N R. 6 W<br>6 miles W of State Line<br>(distance) (direction) (nearest town)  | CLAY                                  | 18   | 65  |
| WELL PURPOSE: Home<br>(home, irrigation, municipal, industrial)  | FINE SAND                             | 65   | 68  |
| WELL COMPLETION DATA:<br>(1) diameter (inches) 2"<br>(2) total depth (feet) 110'<br>(3) static water level (feet) 12' below top of ground.<br>(4) casing PVC, 105' (material) (depth)<br>2" (size) if telescope see back.<br>(5) screen 5' 105' (length) (depth to top)<br>2" PVC #008 (size) (material)<br>(6) pump 34 10 (HP) (yield gpm)<br>110 AC (type power)<br>(7) electric log NO (yes or no)<br>(organization running log)<br>(8) how well bottom plugged | CLAY                                  | 68   | 90  |
|  | FINE SAND                             | 90   | 95  |
|  | CLAY                                  | 95   | 103 |
|  | SAND                                  | 103  | 110 |
| DRILLERS REMARKS:  |                                       |      |     |

RECEIVED OCT 25 1978

S. BO. OF WATER COMMISSIONERS

If well telescopes please sketch and show depths.

GROUND LEVEL

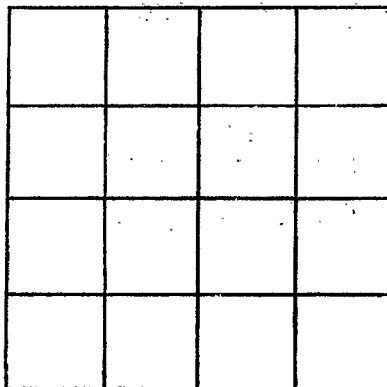

SECTION \_\_\_\_\_

Please indicate well location X.

ADDITIONAL INFORMATION

If more than one screen, show locations of each on sketch.