

WAYNE
Y 2015
11-30-78

**MISSISSIPPI
BOARD OF WATER COMMISSIONERS**
416 North State Street
Jackson, Mississippi 39201

WATER WELL DRILLERS LOG

McILWAIN WATER WELL SERVICE

Nov. 30 19 78 RT. 2 BOX 38 WAYNE
 date well completed firm name county well located
 WAYNESBORO MISS 39367


LANDOWNER:	description of formations encountered	from	to
NORMAN Douglas			
Buckatunna Miss. (mailing address)	SAND	4	8
WELL LOCATION: sec. 29 T. 6 N R. 6 E 9 miles SW of B ^W tunna (distance) (direction) (nearest town)	Clay	8	10
	SAND	10	30
WELL PURPOSE: Home (home, irrigation, municipal, industrial)			
WELL COMPLETION DATA:			
(1) diameter (inches) 2"			
(2) total depth (feet) 30'			
(3) static water level (feet) 24' below top of ground.			
(4) casing PVC, 25' (material) (depth) 2" (size) If telescope see back.			
(5) screen 5', 25' (length) (depth to top) 2" PVC .008 (size) (material)			
(6) pump 1 (HP) 10 (yield gpm) 220 AC (type power)			
(7) electric log No (yes or no)			
(organization running log)			
(8) how well bottom plugged			
DRILLERS REMARKS:			

RECEIVED
JAN 16 1978

MISS. BD. OF WATER COMM.

If well telescopes please sketch and show depths.

GROUND LEVEL

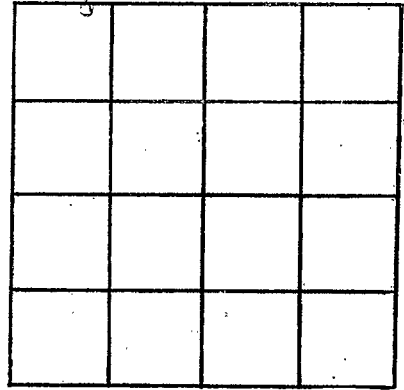

SECTION _____

Please indicate well location X.

ADDITIONAL INFORMATION

If more than one screen,
show locations of each on sketch.