

WAYNE
Y 201e
6-26-79

15

MISSISSIPPI  
BOARD OF WATER COMMISSIONERS  
416 North State Street  
Jackson, Mississippi 39201

WATER WELL DRILLERS LOG  
McILWAIN WATER WELL SERVICE


6-26 1979 RT. 2, BOX 37 WAYNESBORO, MISS. 39367 Wayne  
 date well completed county well located

LANDOWNER:	description of formations encountered	from	to
<u>Landis Rigney</u> <u>Waynesboro Miss</u> (mailing address)			
	<u>Grey Clay</u>	<u>3</u>	<u>12</u>
WELL LOCATION: sec. <u>26</u> T. <u>6</u> N. R. <u>6</u> E <u>7</u> miles <u>SW</u> of <u>Brunna</u> (distance) (direction) (nearest town)	<u>White Coarse Sand</u>	<u>12</u>	<u>30</u>
WELL PURPOSE: <u>Home</u> (home, irrigation, municipal, industrial)			
WELL COMPLETION DATA:			
(1) diameter (inches) <u>2"</u>			
(2) total depth (feet) <u>30'</u>			
(3) static water level (feet) <u>6</u> below top of ground.			
(4) casing <u>PVC</u> , <u>25'</u> (material) (depth) <u>2"</u> If telescope see back. (size)			
(5) screen <u>5'</u> , <u>25'</u> (length) (depth to top) <u>2"</u> , <u>PVC .008</u> (size) (material)			
(6) pump <u>1</u> <u>12</u> (HP) (yield gpm) <u>220 AC</u> (type power)			
(7) electric log <u>No</u> (yes or no) (organization running log)			
(8) how well bottom plugged			
DRILLERS REMARKS:			

Miss. Board of Water Comm.  
AUG 9 1979  
RECEIVED

If well telescopes please sketch and show depths.

GROUND LEVEL

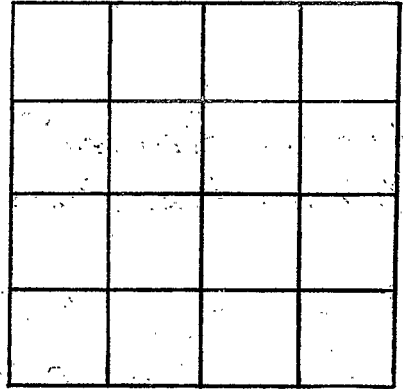

SECTION \_\_\_\_\_

Please indicate well location X.

ADDITIONAL INFORMATION

If more than one screen,  
show locations of each on sketch.